



REEF LIGHTING
WHERE LIGHT TOUCHES THE SEA

PROJECT:

PO 5230

±5MM
Size tolerance
± 1/2"
Angle tolerance



Date: 07-08-2023

Revision:

Type: Pendant lamp

Item No: 9383-BS

Dwg by:

Verification by:

Scale: 1: 14

Area/Location:

Dimension:

29.1"L x 29.1"W x 100"OAH

Finish: Brass + White

Materials: Stainless steel + Iron + Glass

Weight: 28 kgs

Light: G9 sockets *18pcs / Bulbs excluded

Qty: 2 pcs

Approved

Approved as noted

Revise & resubmit

Date: _____



Signature: _____

Notes:

- *1: Different design & size canopy from original.
- *2: Different mounting structure from original.
- *3: Different support housing structure from original.
- *4: Additional added secure hanging wires.



Reef Lighting, Inc. reserves the right to change or modify the product specifications without notification.

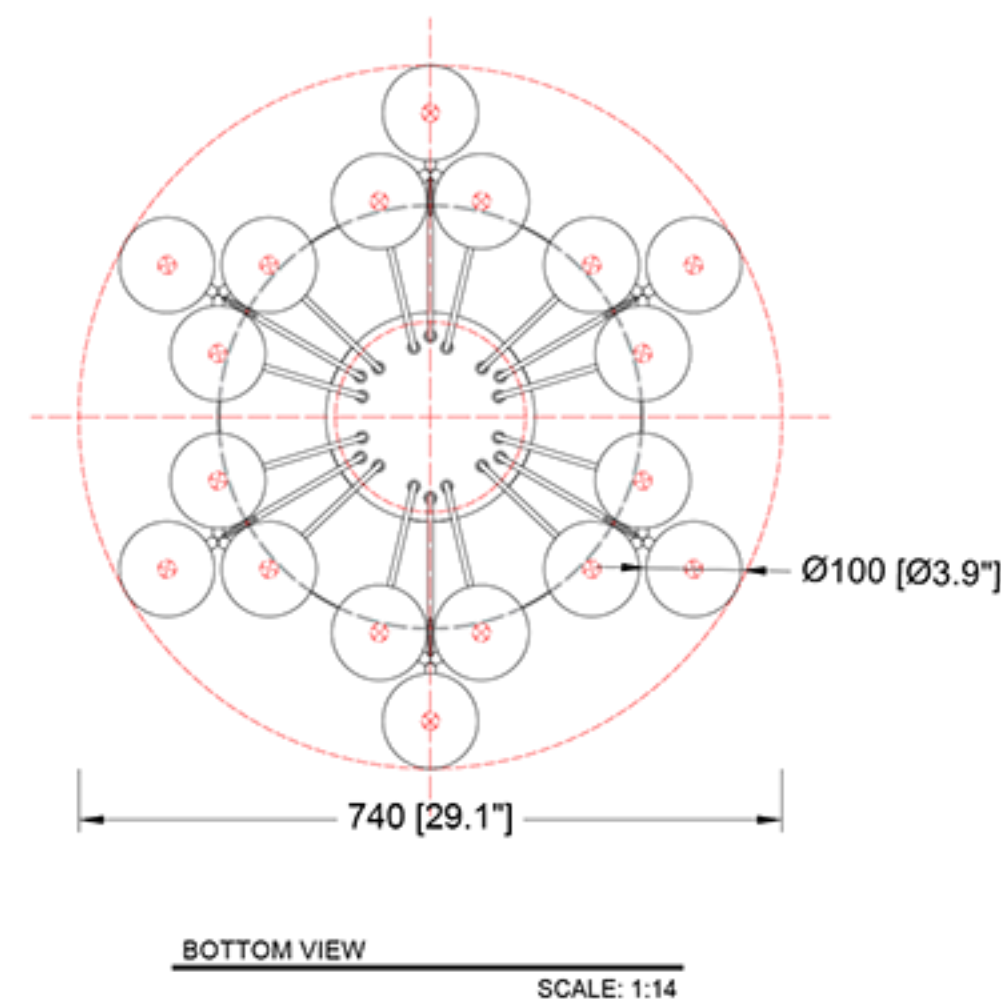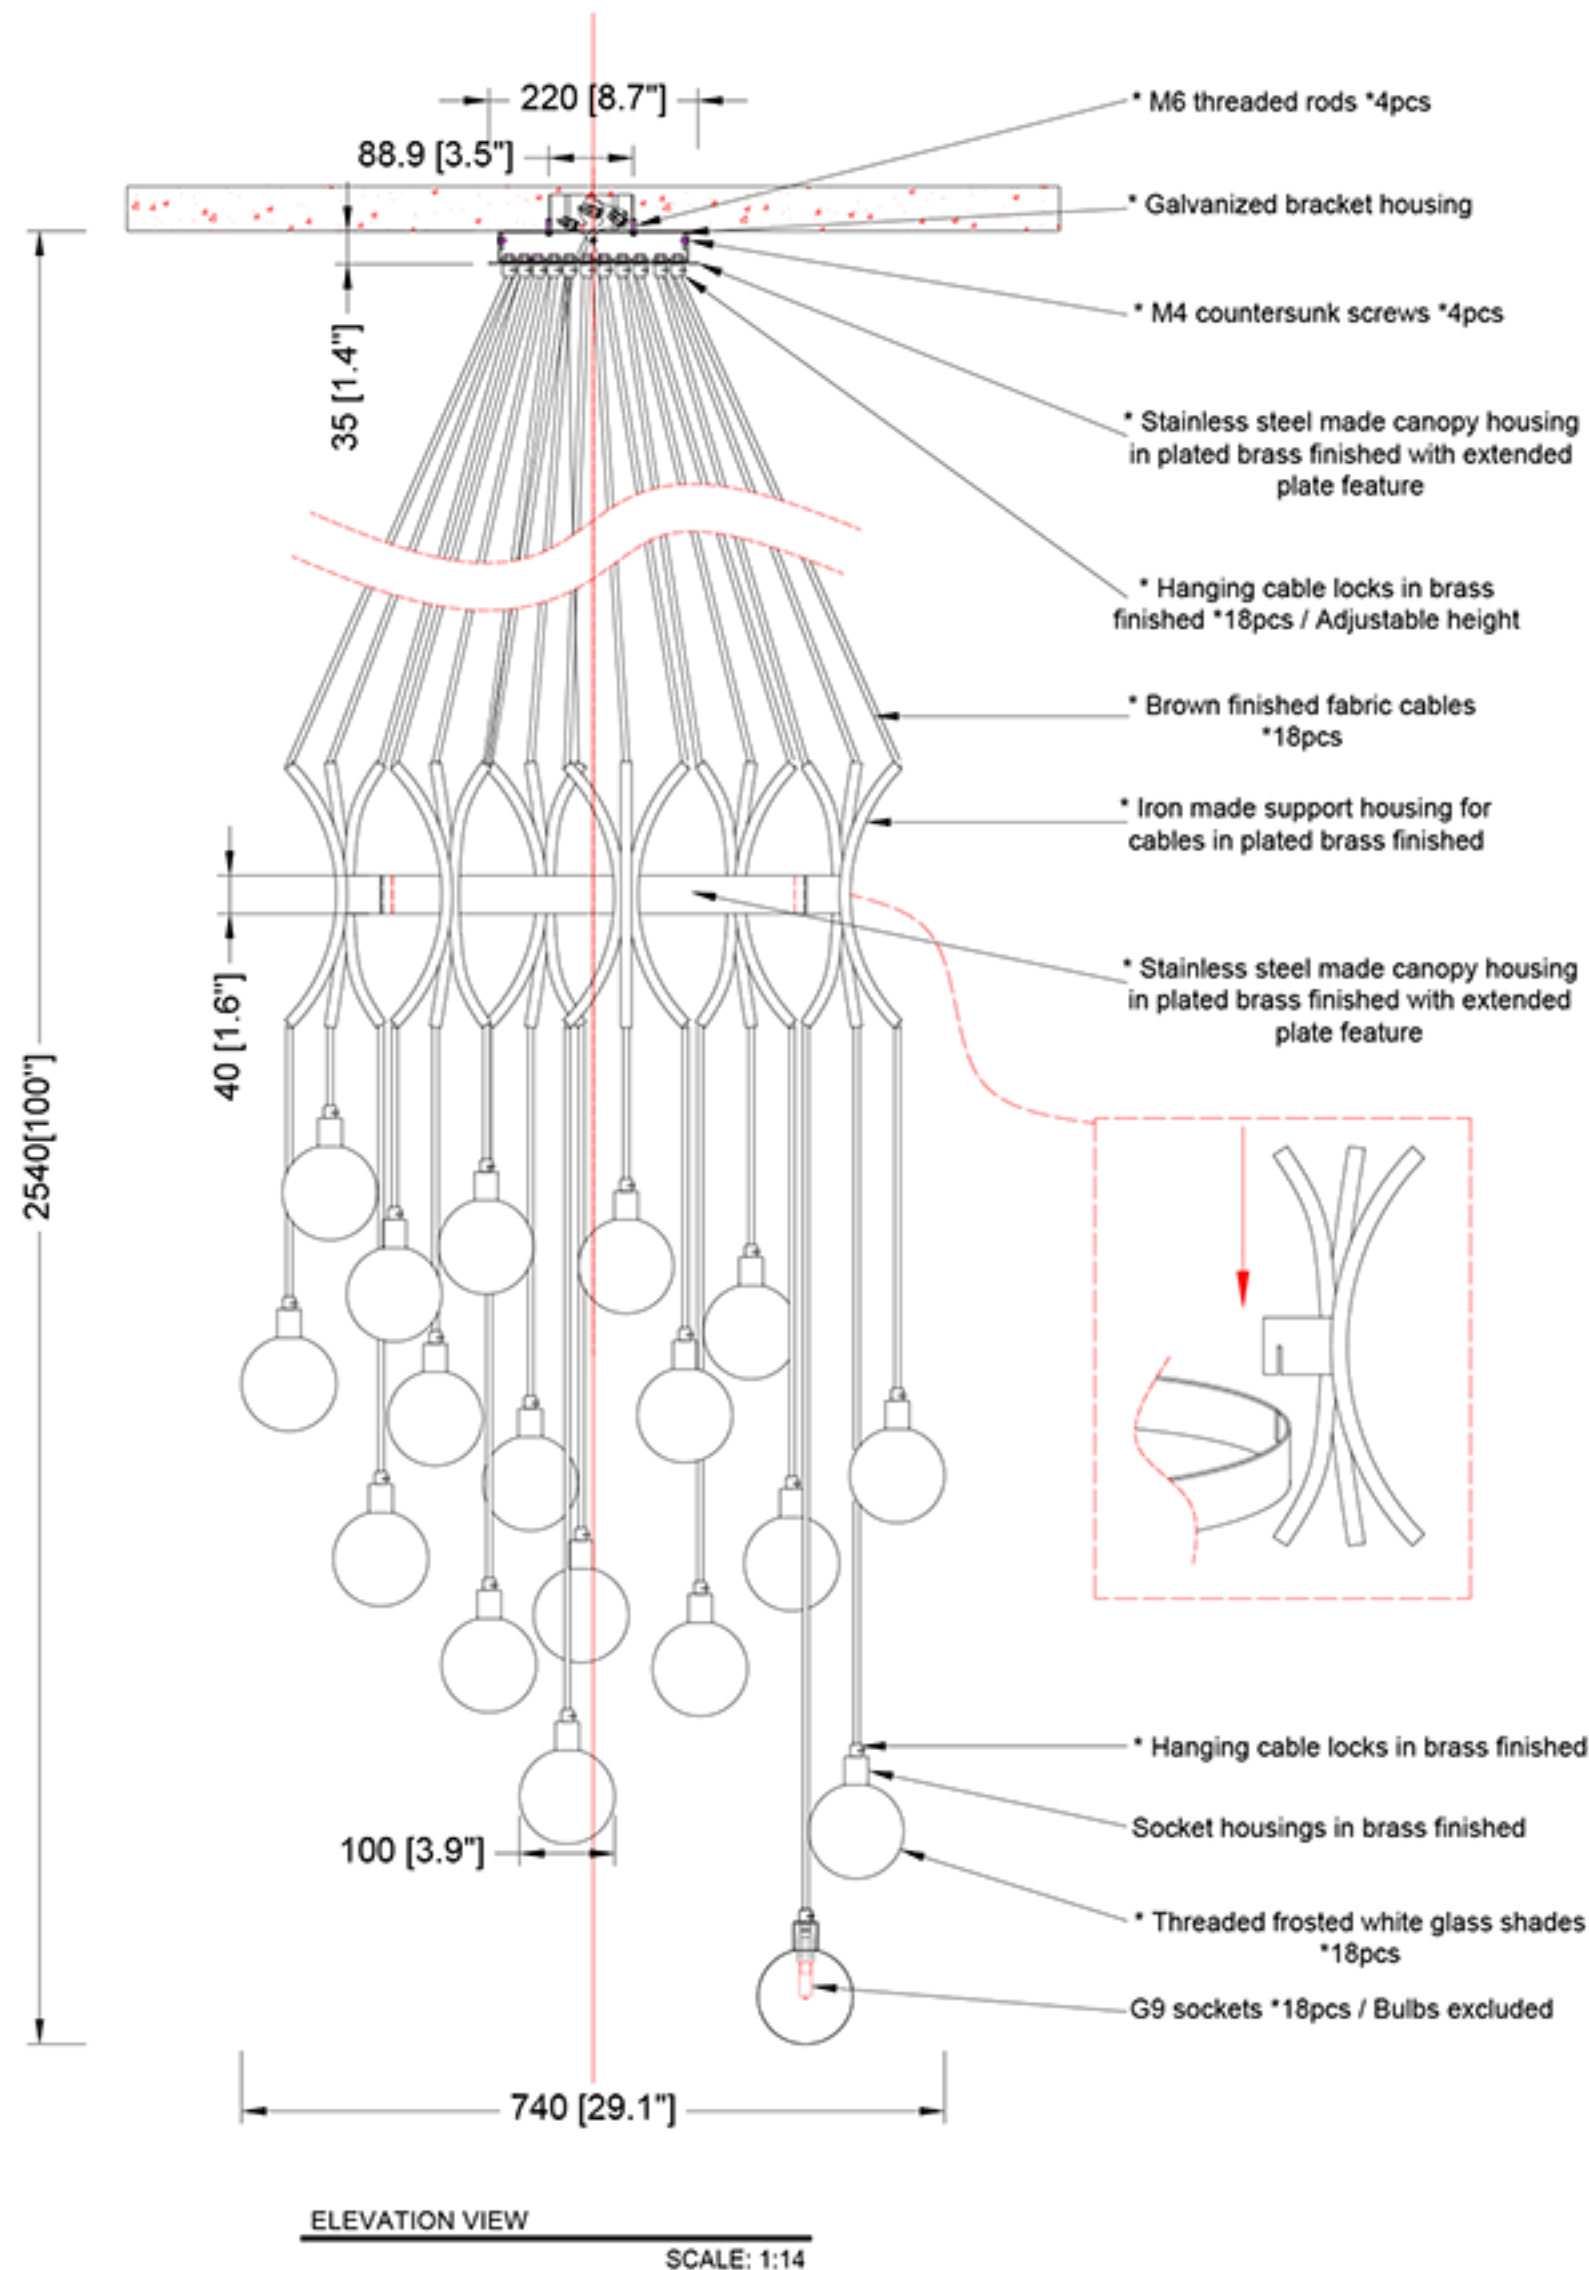

Ref Pic

SCALE: NTS