



REEF LIGHTING
WHERE LIGHT TOUCHES THE SEA

PROJECT:

PO 5230

±5MM
Size tolerance
± 1/2"
Angle tolerance



Date: 07-08-2023

Revision:

Type: Pendant lamp

Item No: 9222-1-WH

Dwg by:

Verification by:

Scale: 1: 13

Area/Location:

Dimension:

41.3"L x 7.9"W x 45"H

Finish: Black + White

Materials: Stainless steel + Alu + Glass

Weight: 4 kgs

Light: Osram LED 7W 3000K *2pcs / Triac dimming

Qty: 1 pcs

Approved

Approved as noted





Revise & resubmit

Date: _____

Signature: _____

Notes:

- *1: Different mounting design from original.
- *2: Different LED light & structure from original.
- *3: Different but similar alu chains from original.
- *4: Original design has no Triac dimming function.

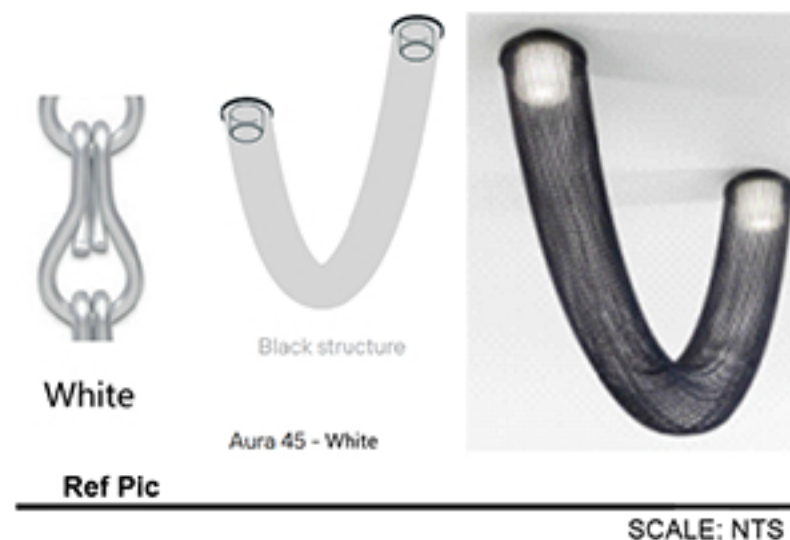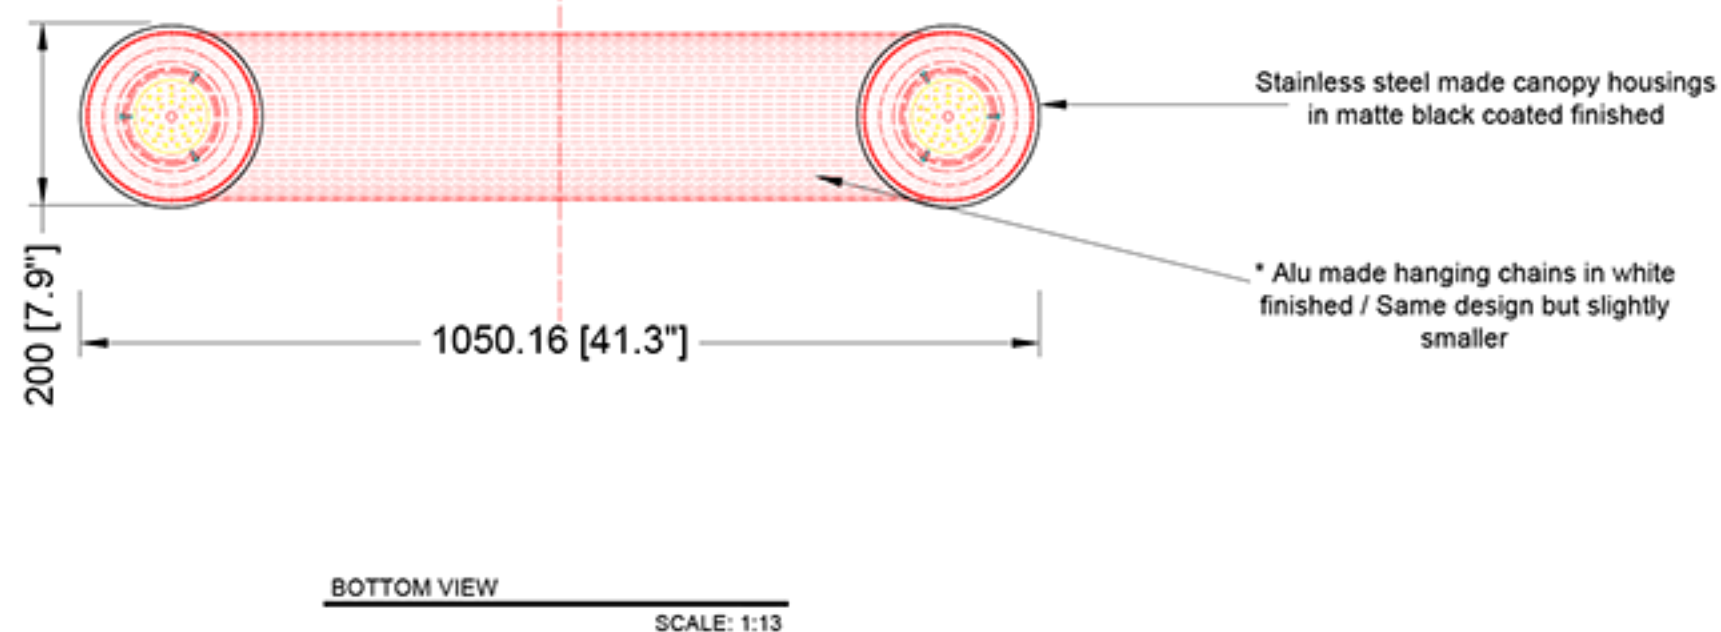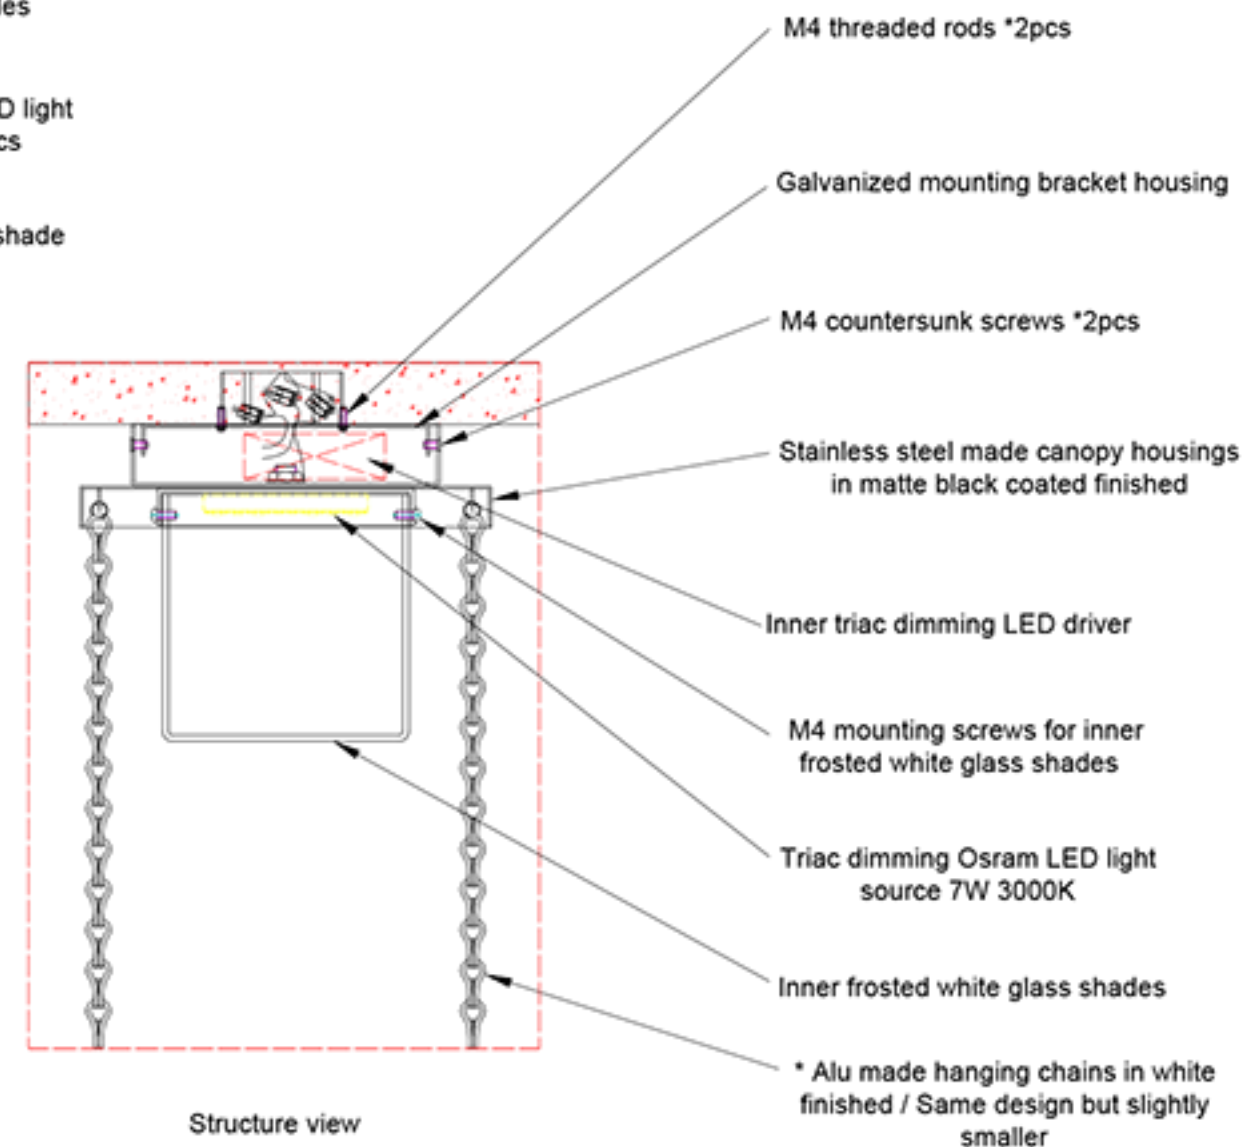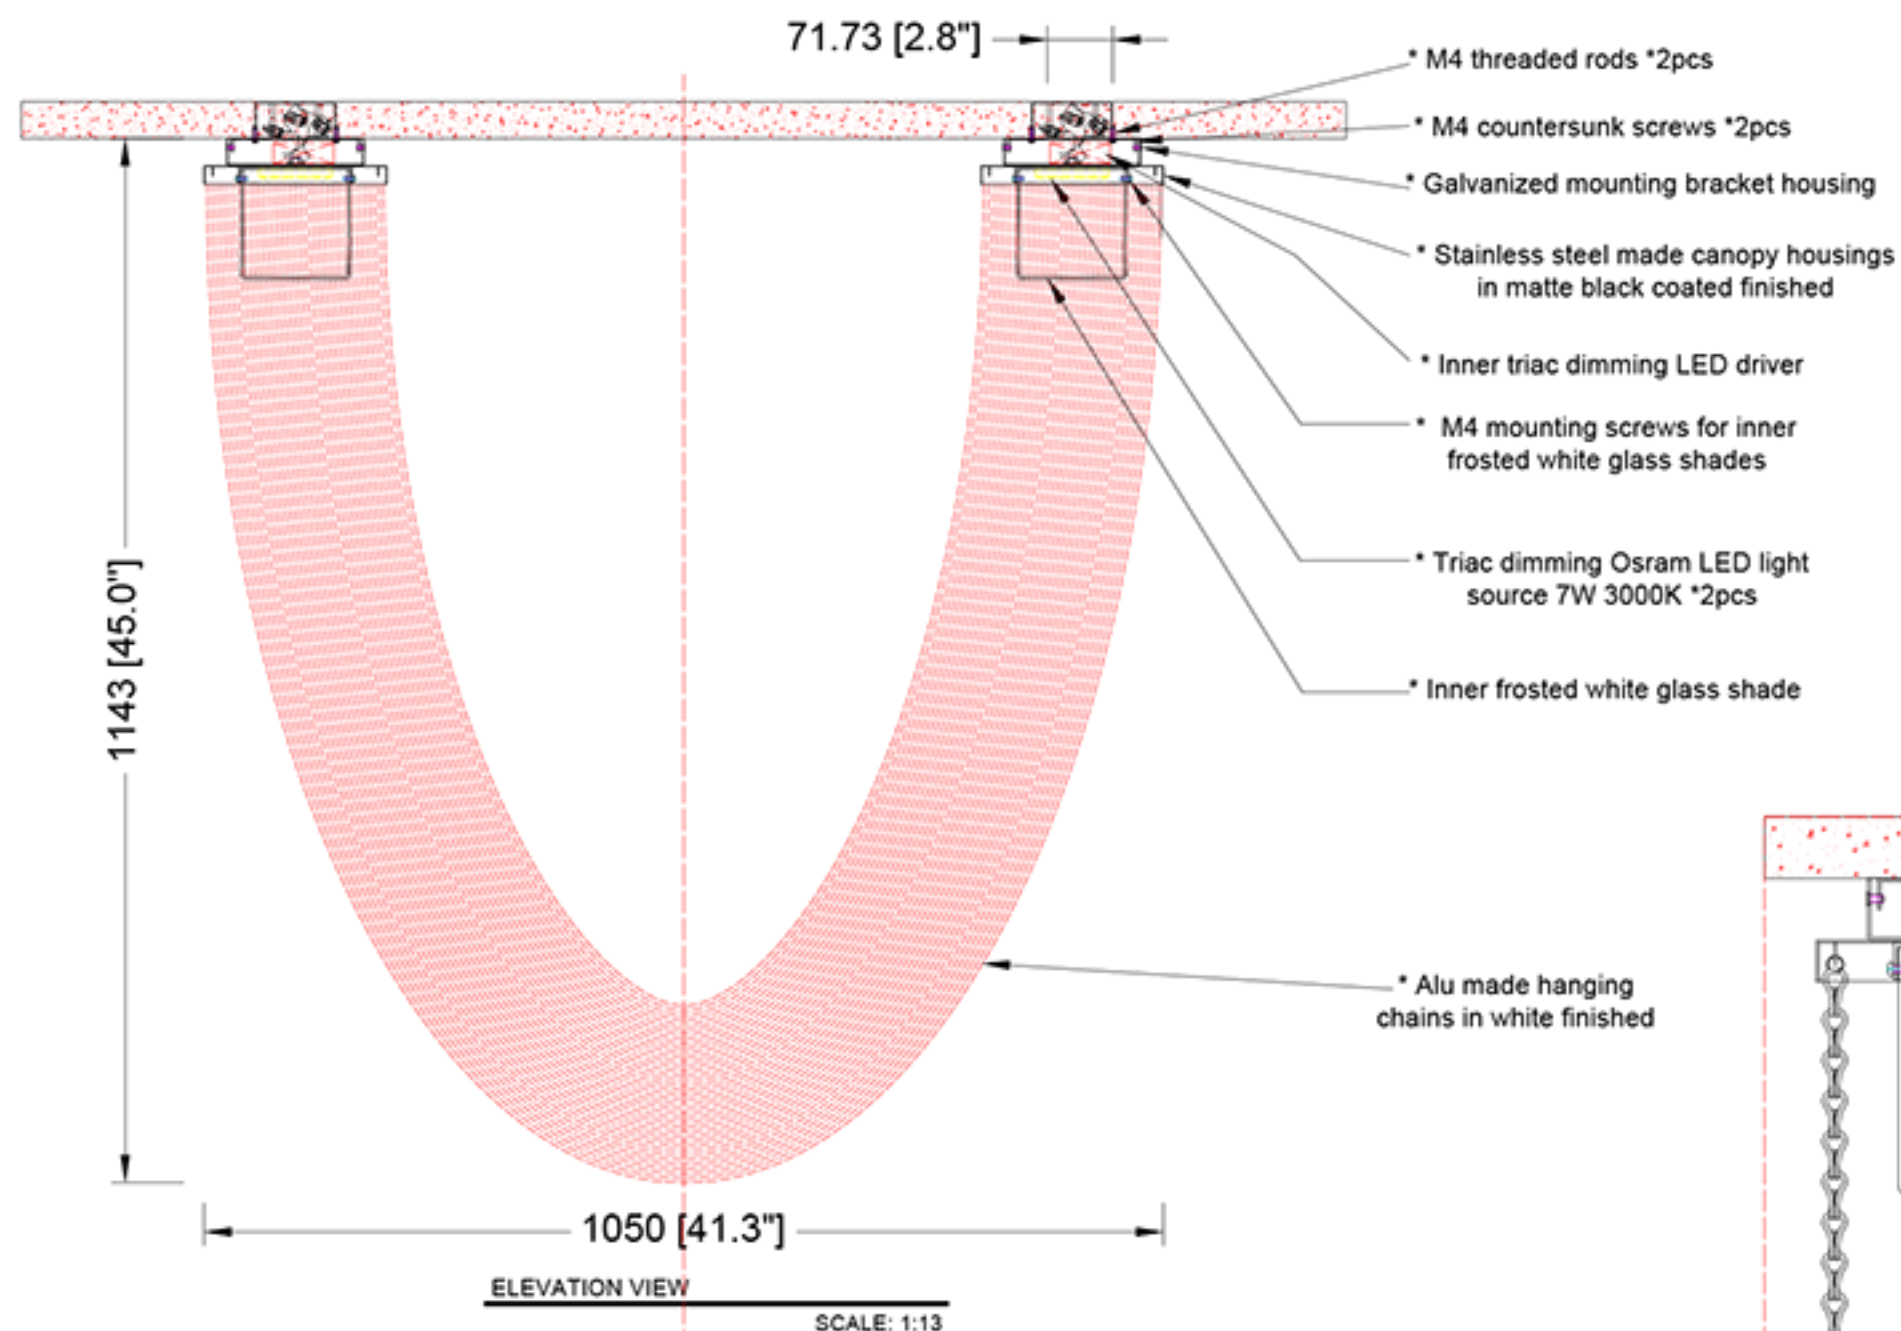

Reef Lighting, Inc. reserves the right to change or modify the product specifications without notification.