



REEF LIGHTING
WHERE LIGHT TOUCHES THE SEA

PROJECT:

PO 5230

±5MM
Size tolerance
± 1/2"
Angle tolerance



Date: 07-08-2023

Revision:

Type: Pendant lamp

Item No: 9616-36-L-WH

Dwg by:

Verification by:

Scale: 1: 10

Area/Location:

Dimension:

39.4"L x 15.7"W x 120"OAH

Finish: White

Materials: Stainless steel Iron + Alu + Acrylic

Weight: 25 kgs

Light: Osram LED light 3W *36pcs 3000K /
Triac dimming

Qty: 1 pcs

Approved

Approved as noted




Revise & resubmit

Date: _____

Signature: _____

Notes:

- *1: Different design & size canopy from original.
- *2: Different LED light & structure from original.
- *3: Different mounting structure from original.
- *4: Different hanging height from original.
- *5: Triac dimming function on fixture.

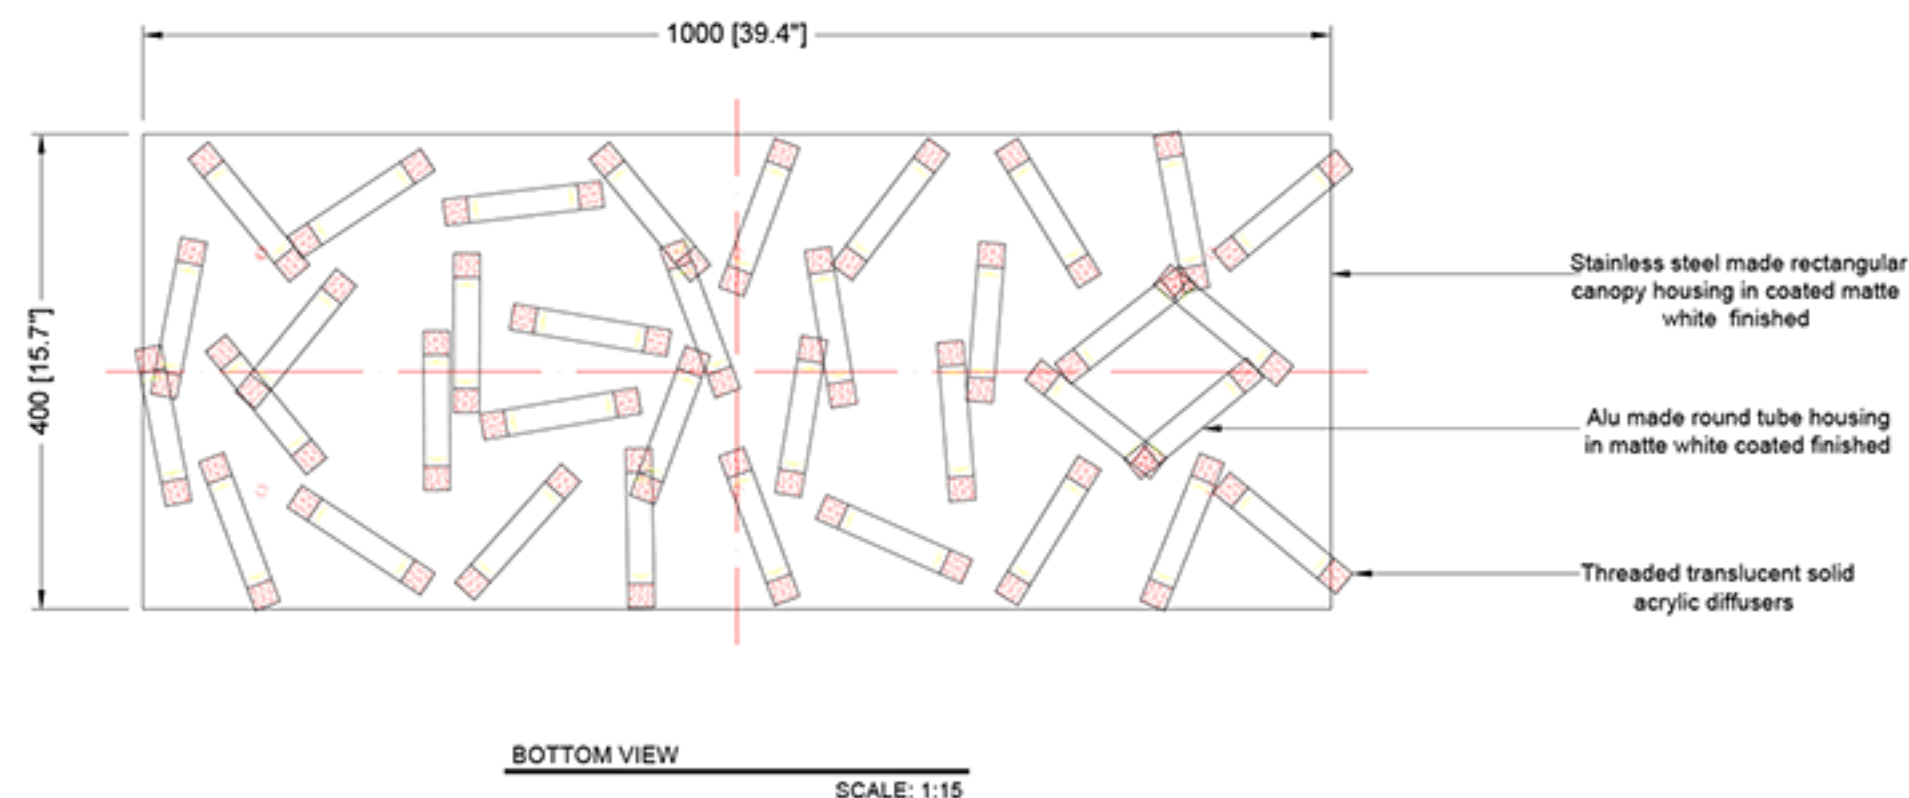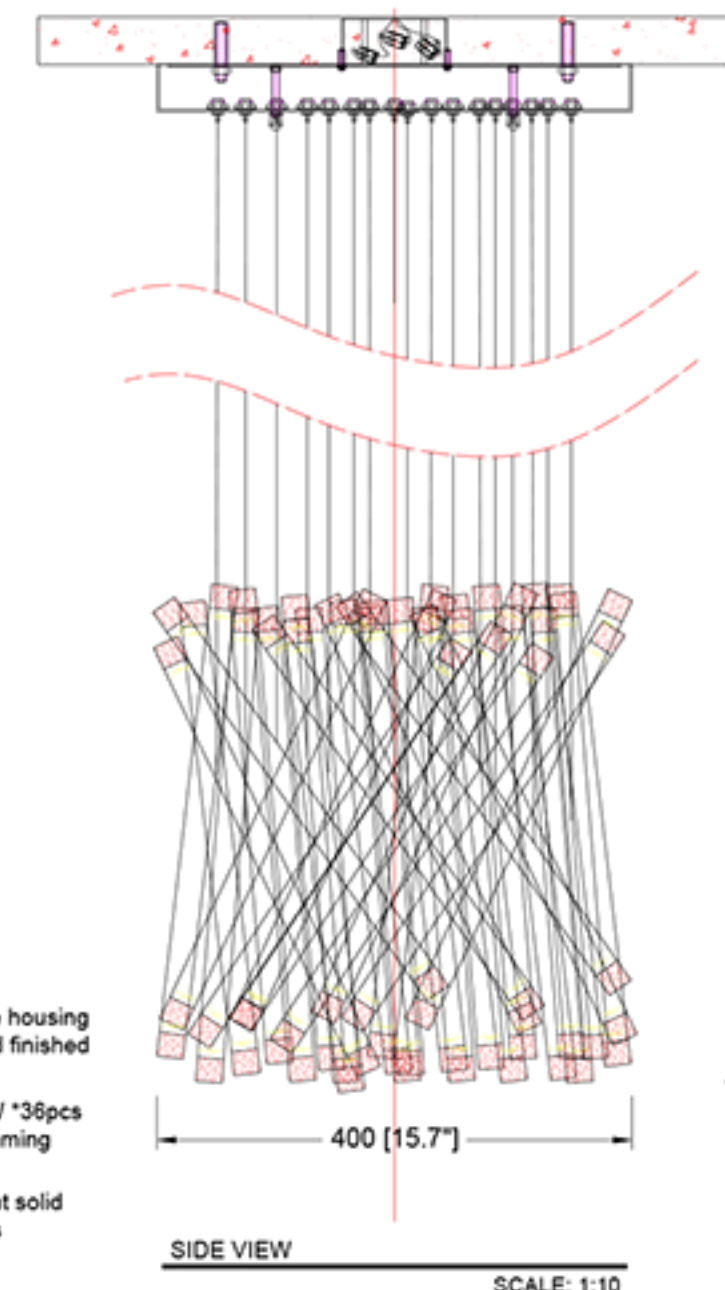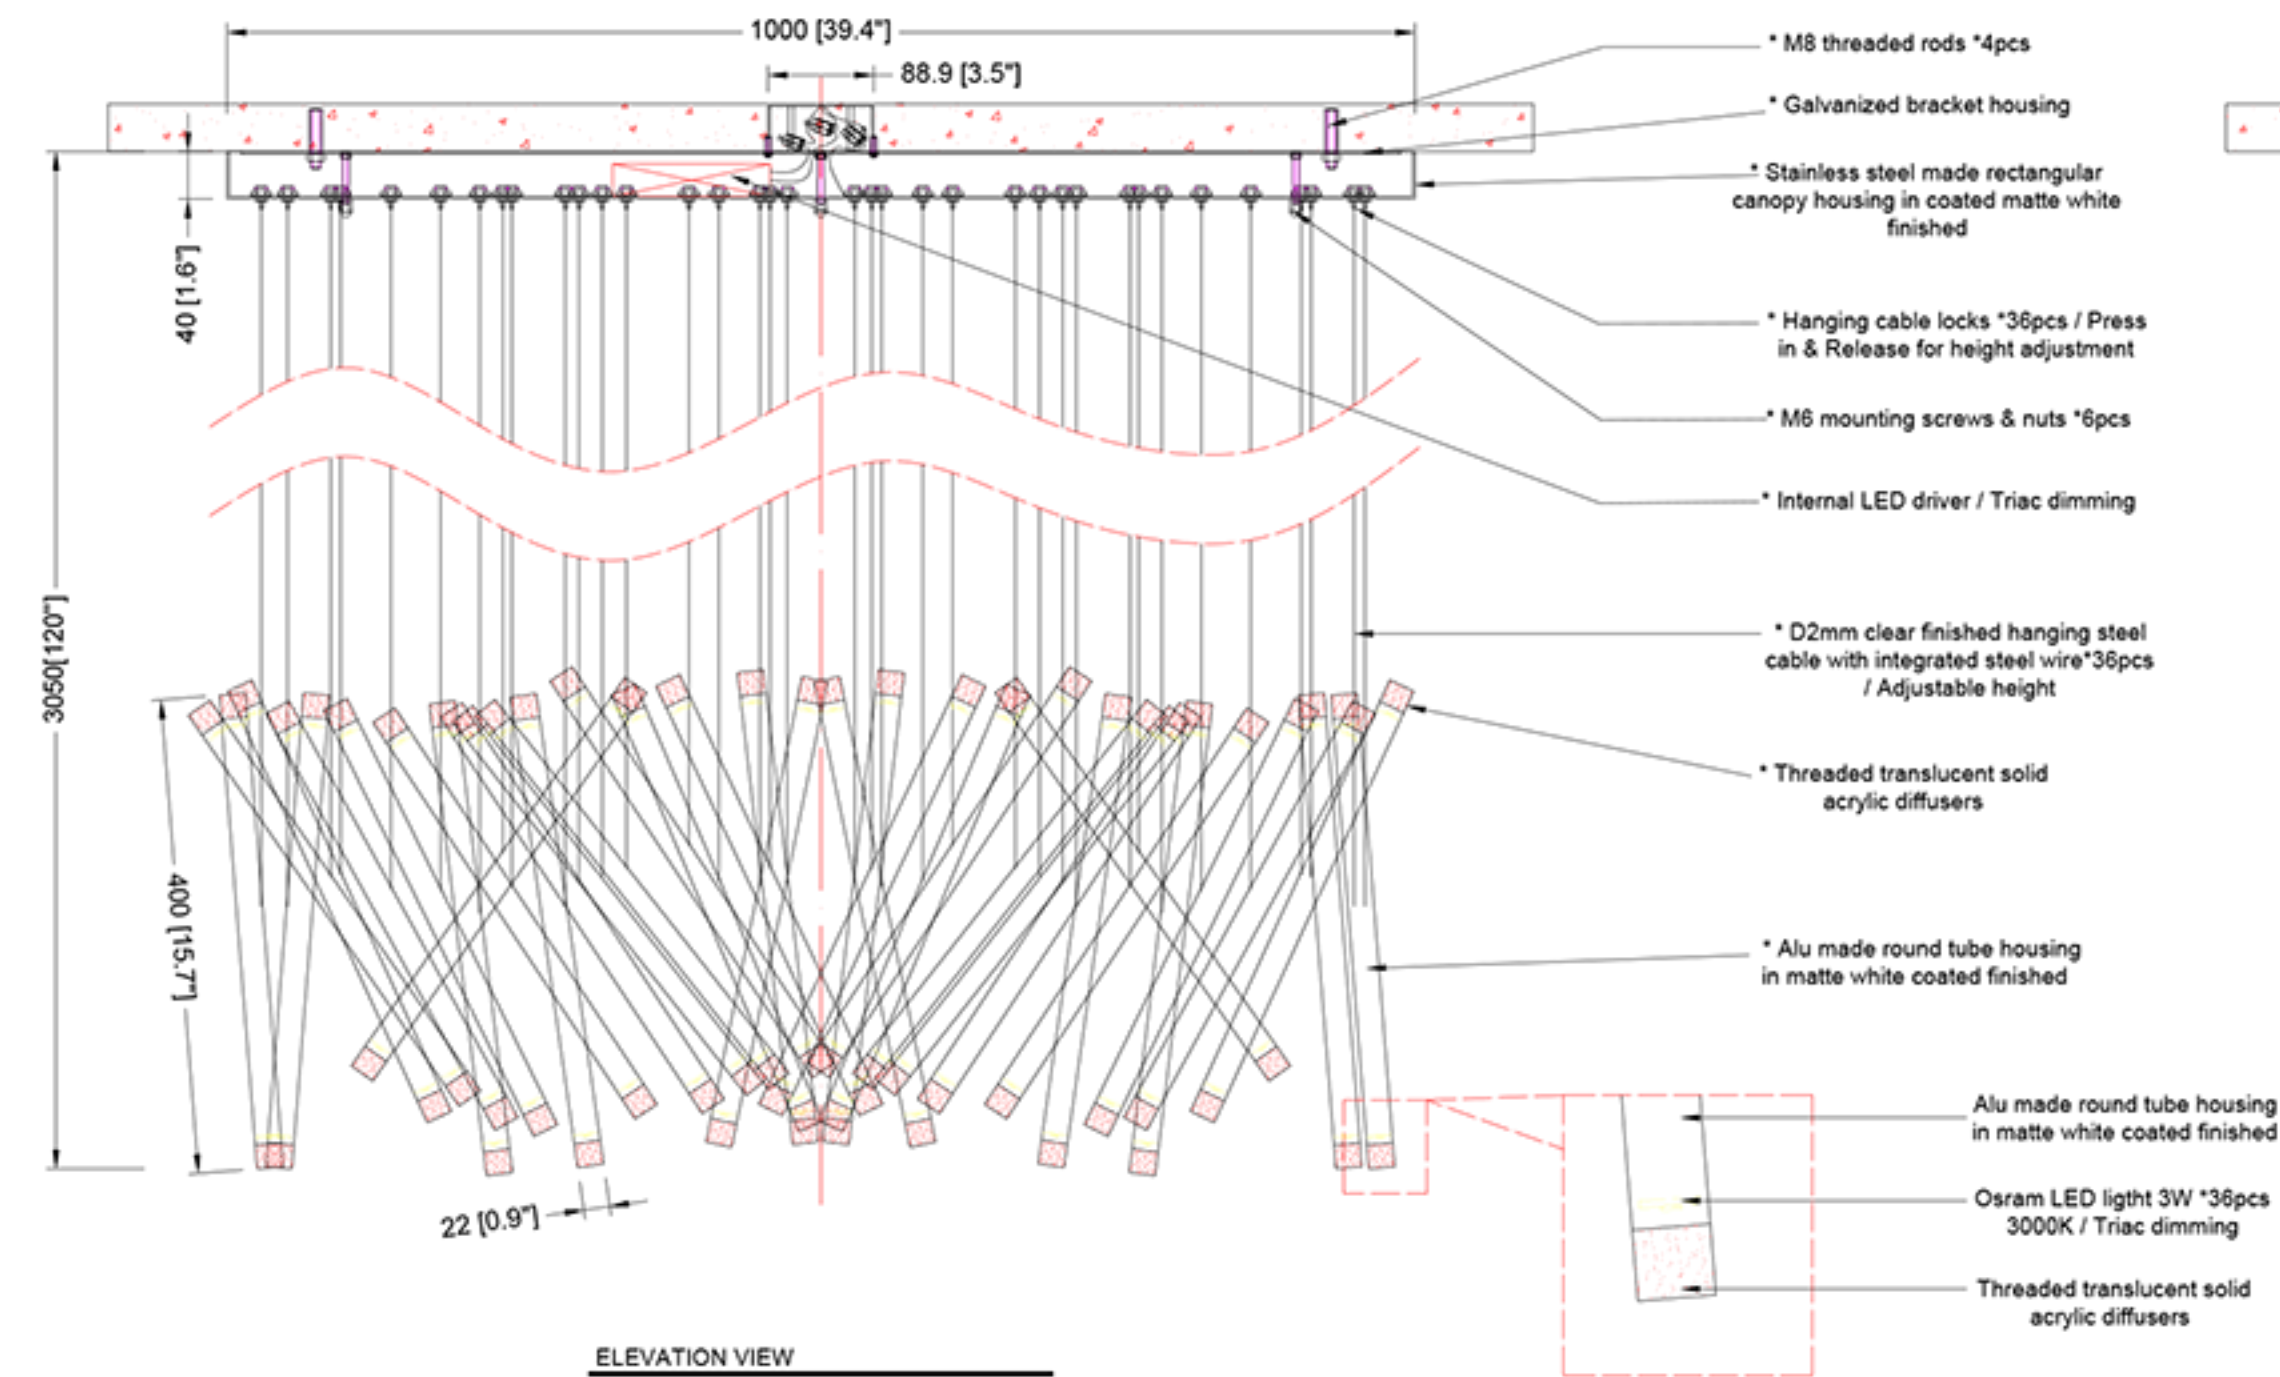

Ref Pic

SCALE: NTS



Reef Lighting, Inc. reserves the right to change or modify the product specifications without notification.