



REEF LIGHTING
WHERE LIGHT TOUCHES THE SEA

PROJECT:

PO 5230

±5MM
Size tolerance
± 1/2°
Angle tolerance



Date: 07-08-2023

Revision:

Type: Wall sconce

Item No: 9634-PN

Dwg by:

Verification by:

Scale: 1: 10

Area/Location:

Dimension:

23.6"L x 25.4"H x 11.8"depth

Finish: Polished nickel + Clear glass

Materials: Iron + Glass

Weight: 3 kgs

Light: G9 sockets *4pcs / Bulbs excluded

Qty: 4 pcs

Approved

Approved as noted

Revise & resubmit

Date: _____

Signature: _____

Notes:


*1: Different design & size canopy from original.

*2: Different mounting structure from original.

*3: Different but similar fixture size from original.



Reef Lighting, Inc. reserves the right to change or modify the product specifications without notification.

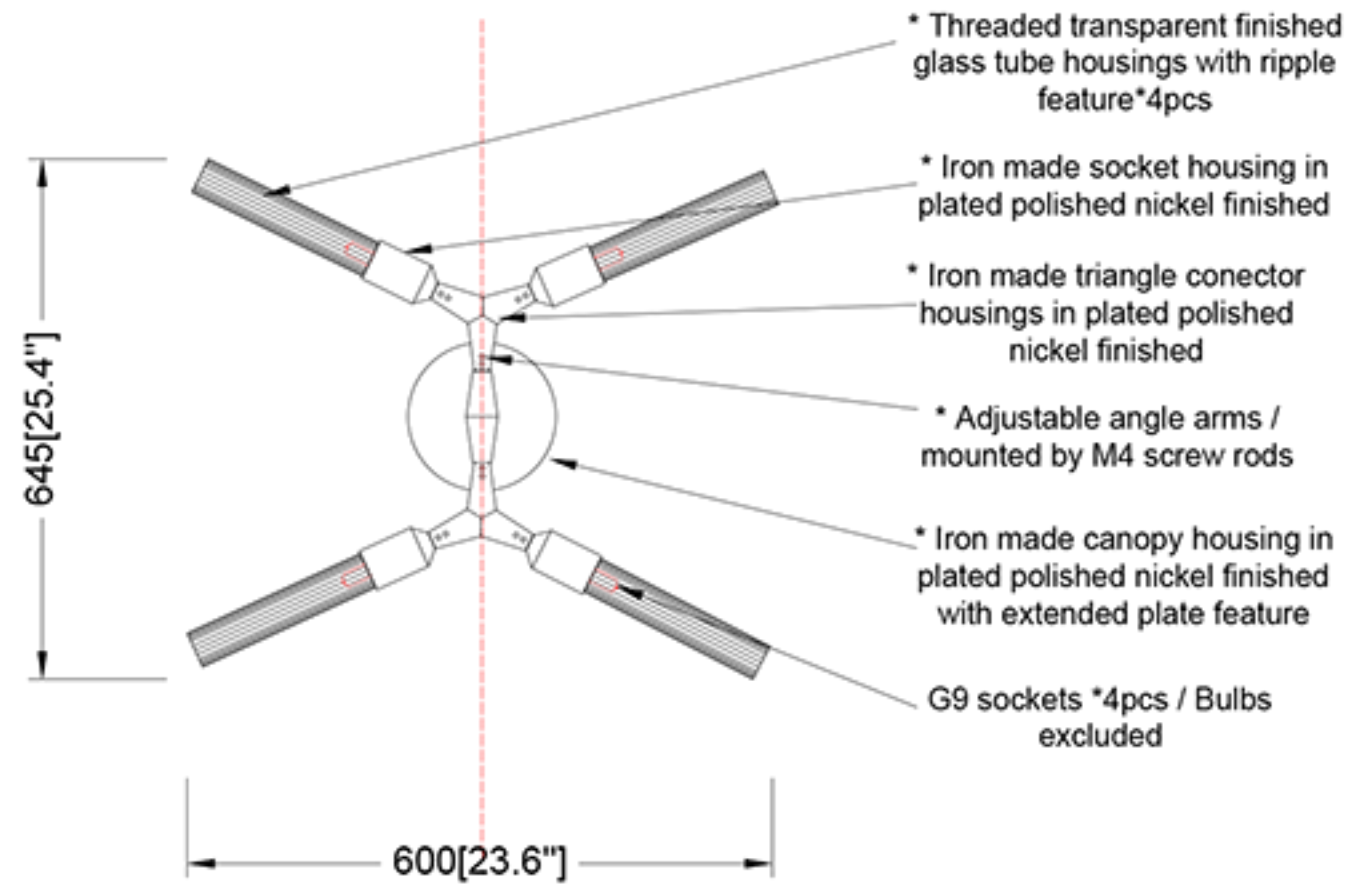


ELEVATION VIEW

SCALE: 1:10




Ref Pic

SCALE: NTS

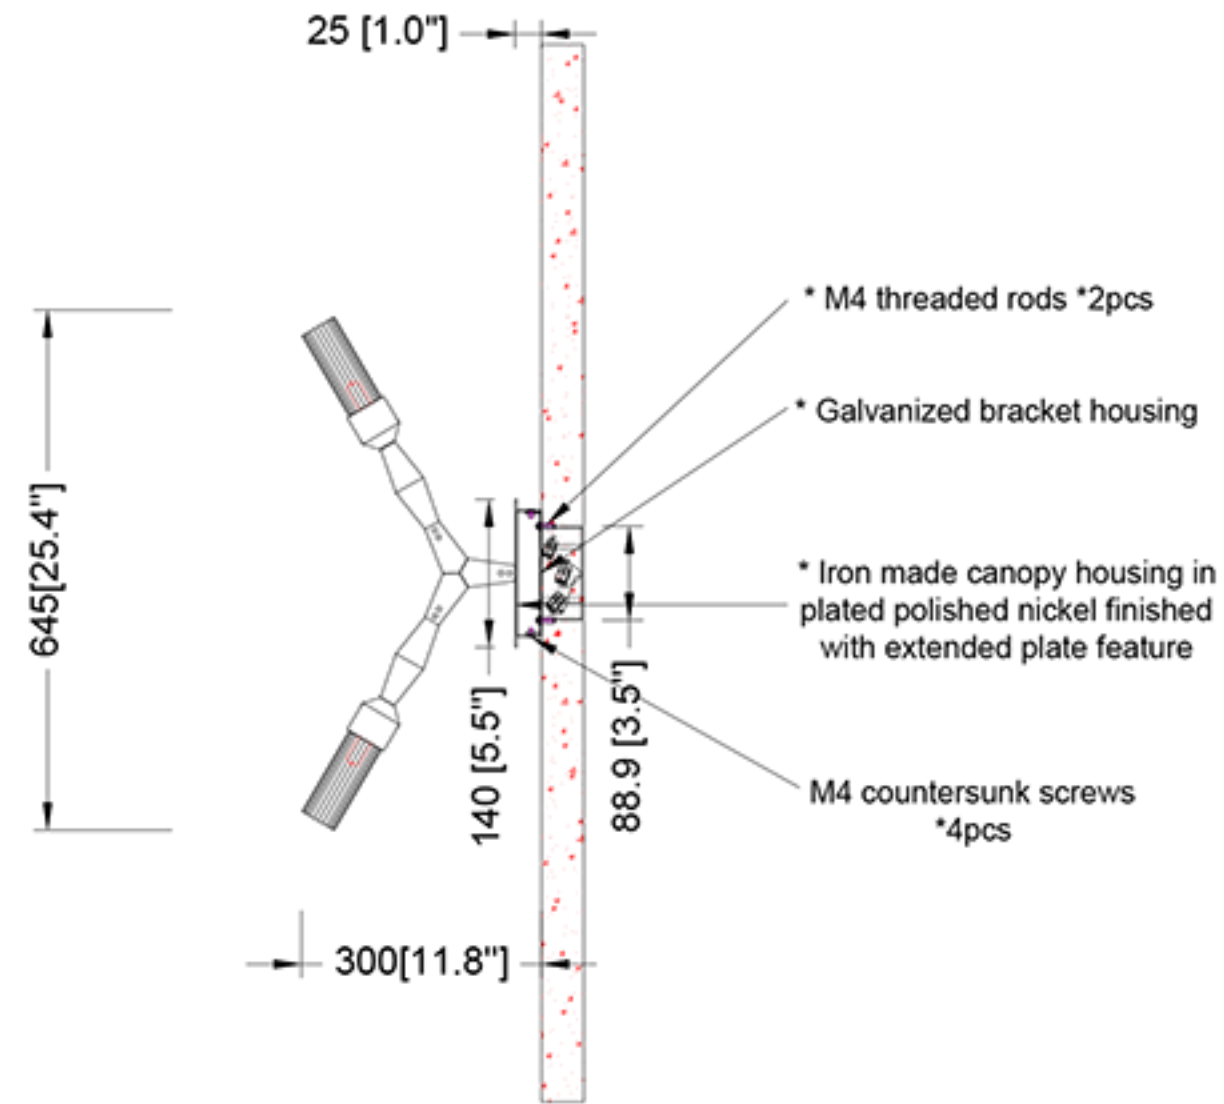

SIDE VIEW

SCALE: 1:10

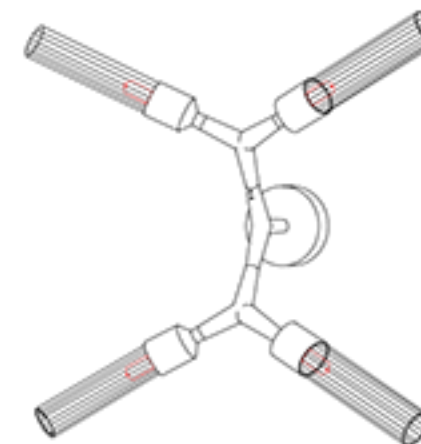

Different angle adjustment Ref view