


REEF LIGHTING
WHERE LIGHT TOUCHES THE SEA

PROJECT:

PO 5230

±5MM
Size tolerance
± 1/2°
Angle tolerance

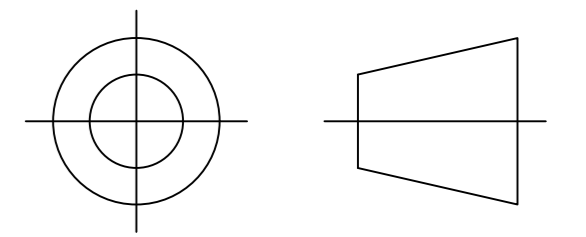

Date: 27-07-2023

Revision:

Type: Pendant lamp

Item No: 9661-S-PN

Dwg by:

Verification by:

Scale: 1: 10

Area/Location:

Dimension:
23.6"L x 23.6"W x 47.2"H

Finish: Polished nickel+ White

Materials: Stainless steel + Alu + Acrylic

Weight: 10 kgs

Light: Osram LED light 15W 3000K *2pcs
/ Triac dimming

Qty: 3 pcs

Approved

Approved as noted





Revise & resubmit

Date: _____

Signature: _____

Notes:

- *1: Different design & size canopy from original.
- *2: Different mounting structure from original.
- *3: Different but similar hanging support housing from original.
- *4: Different LED light & structure from original.
- *5: Triac dimming function.

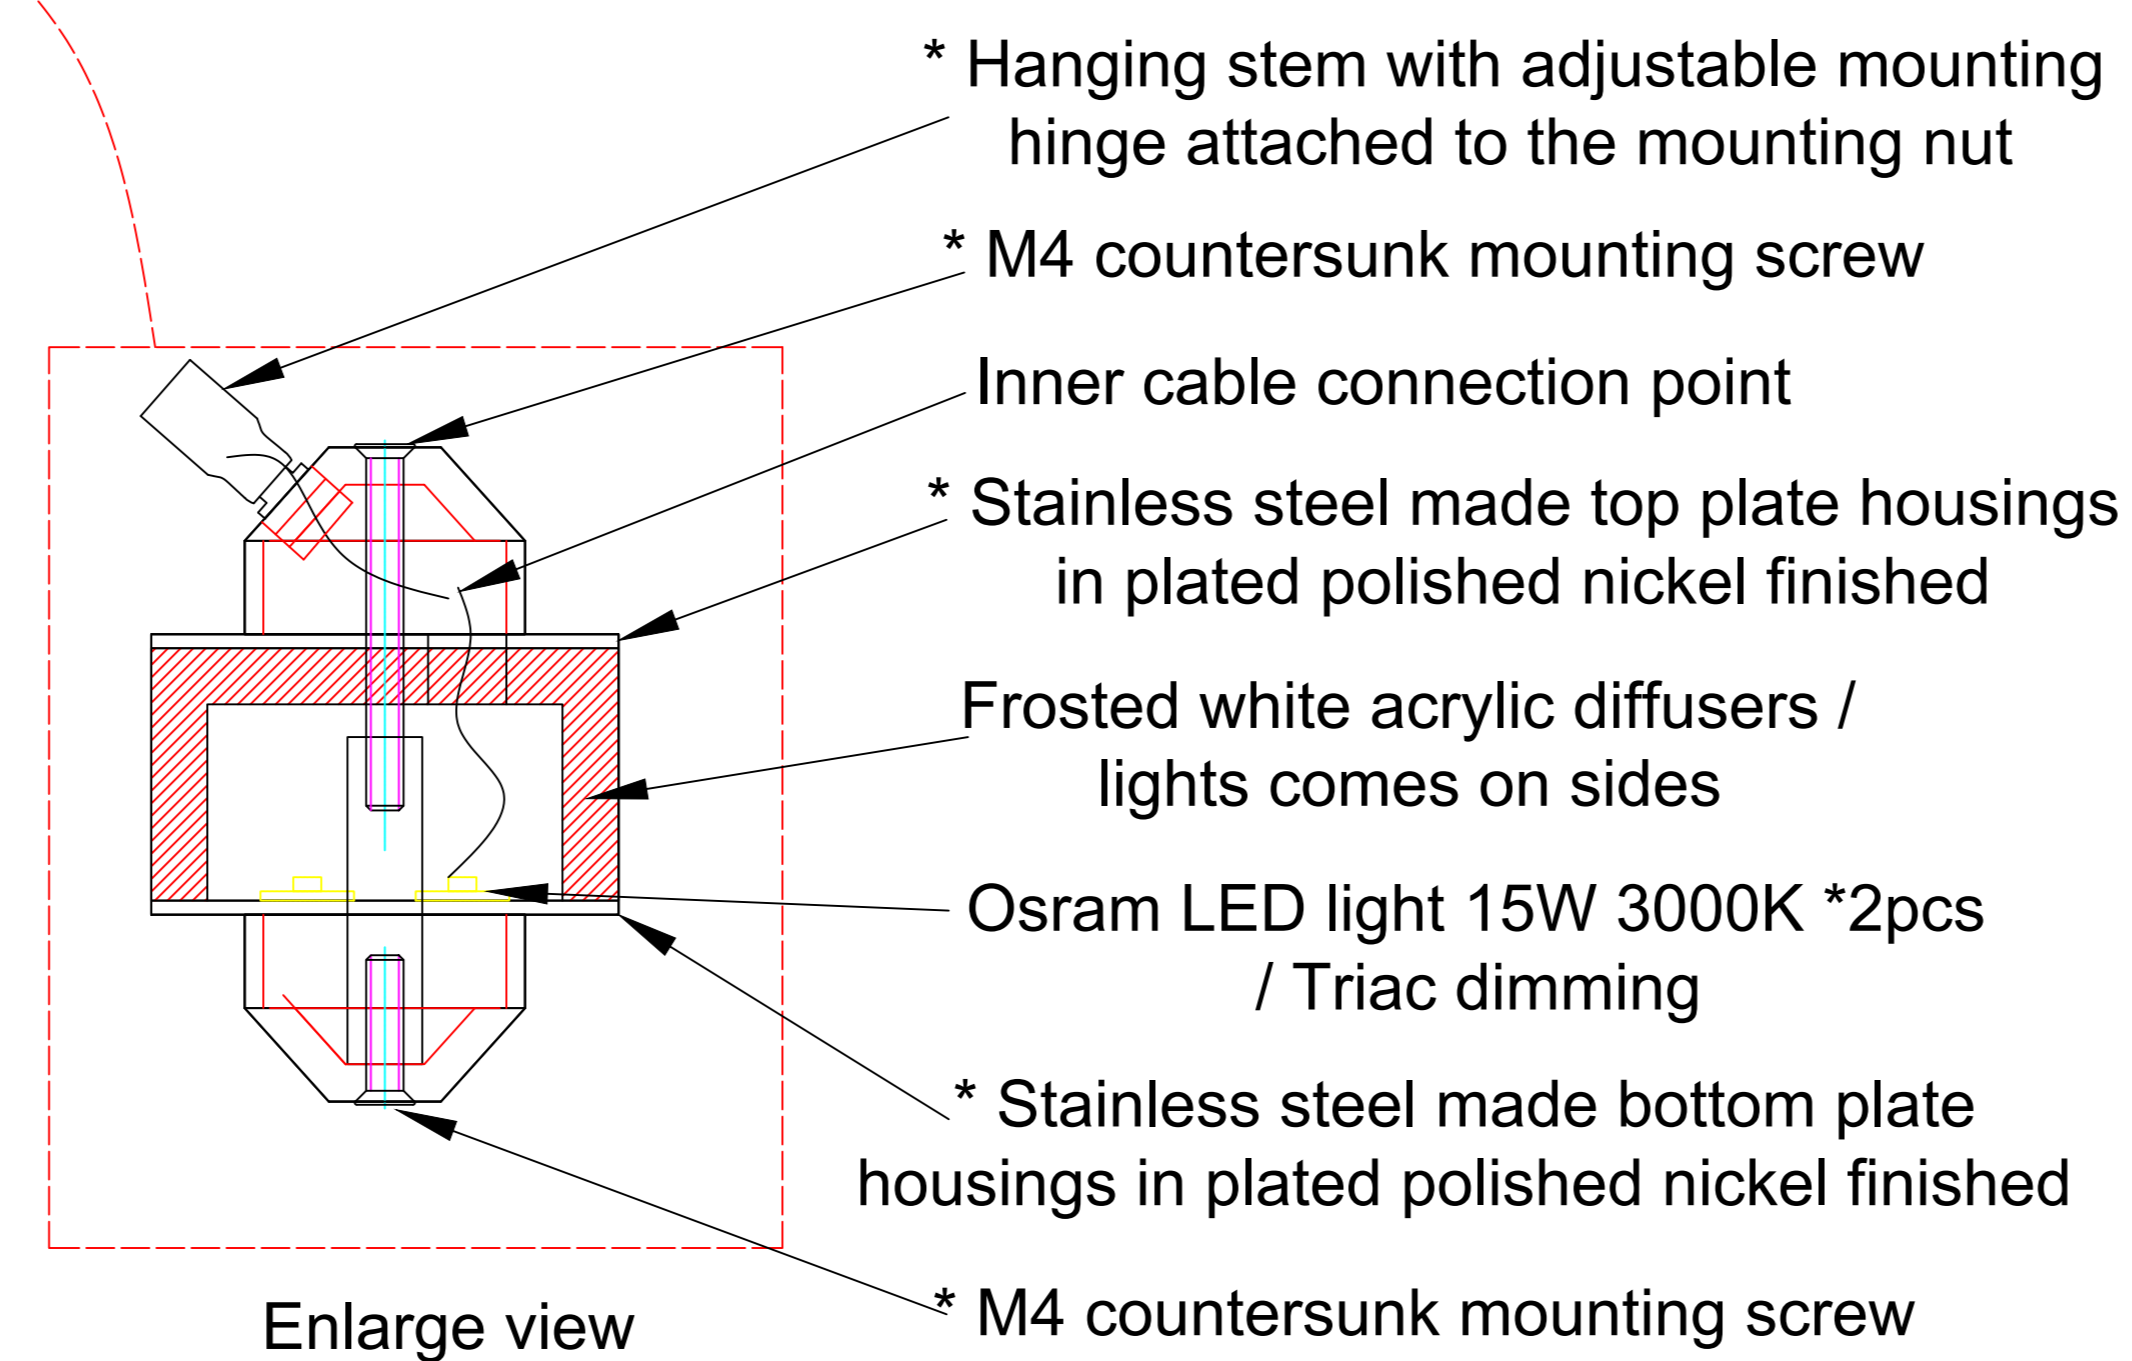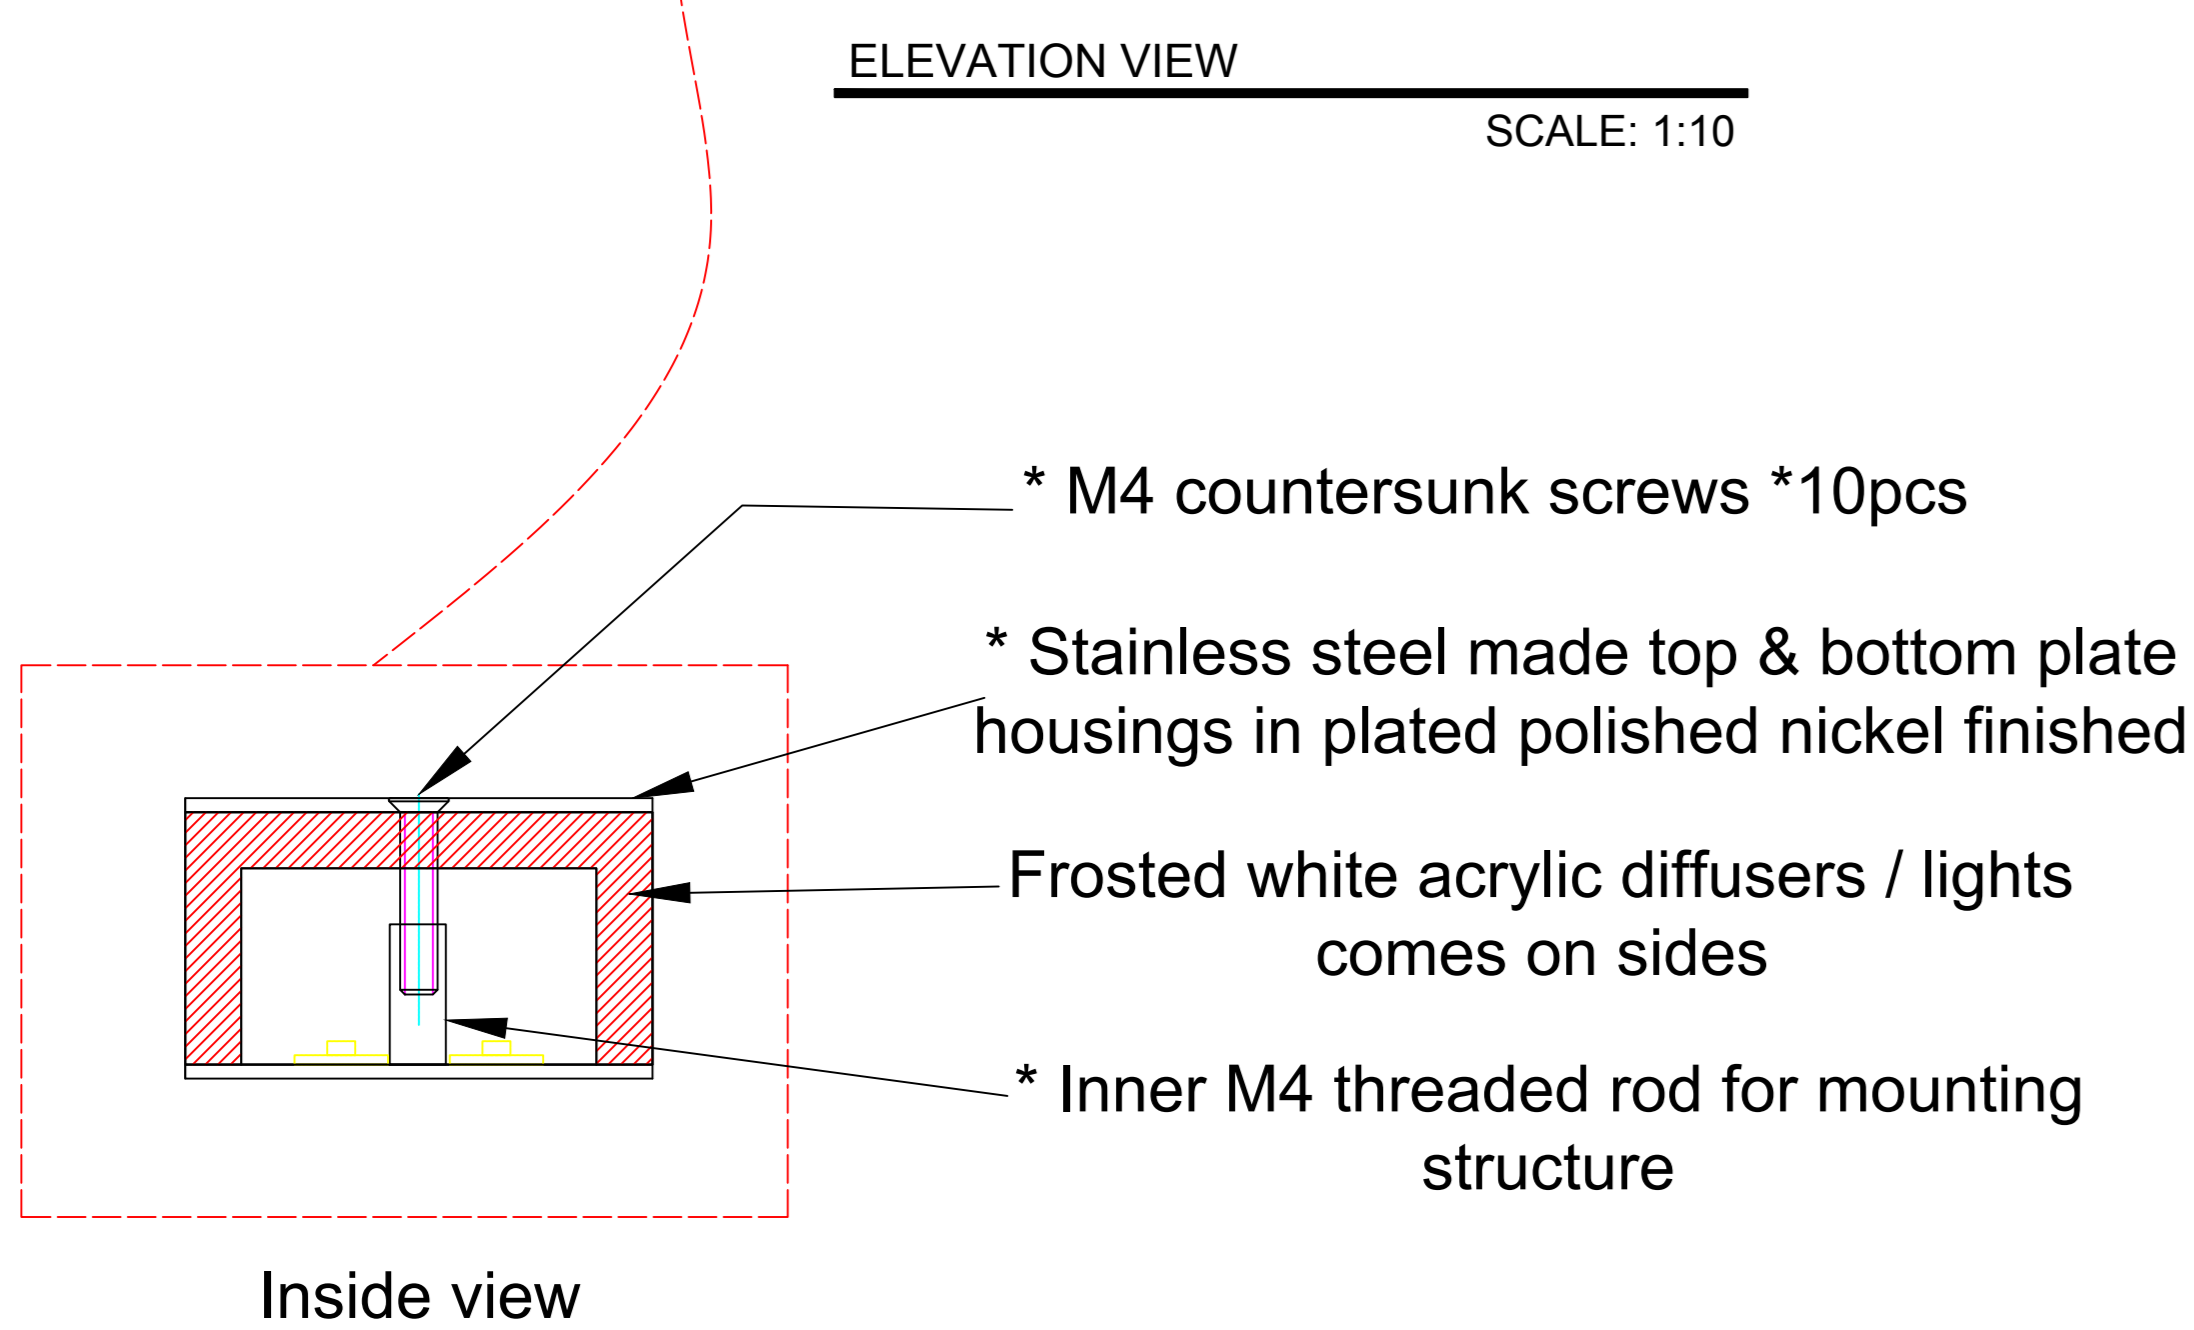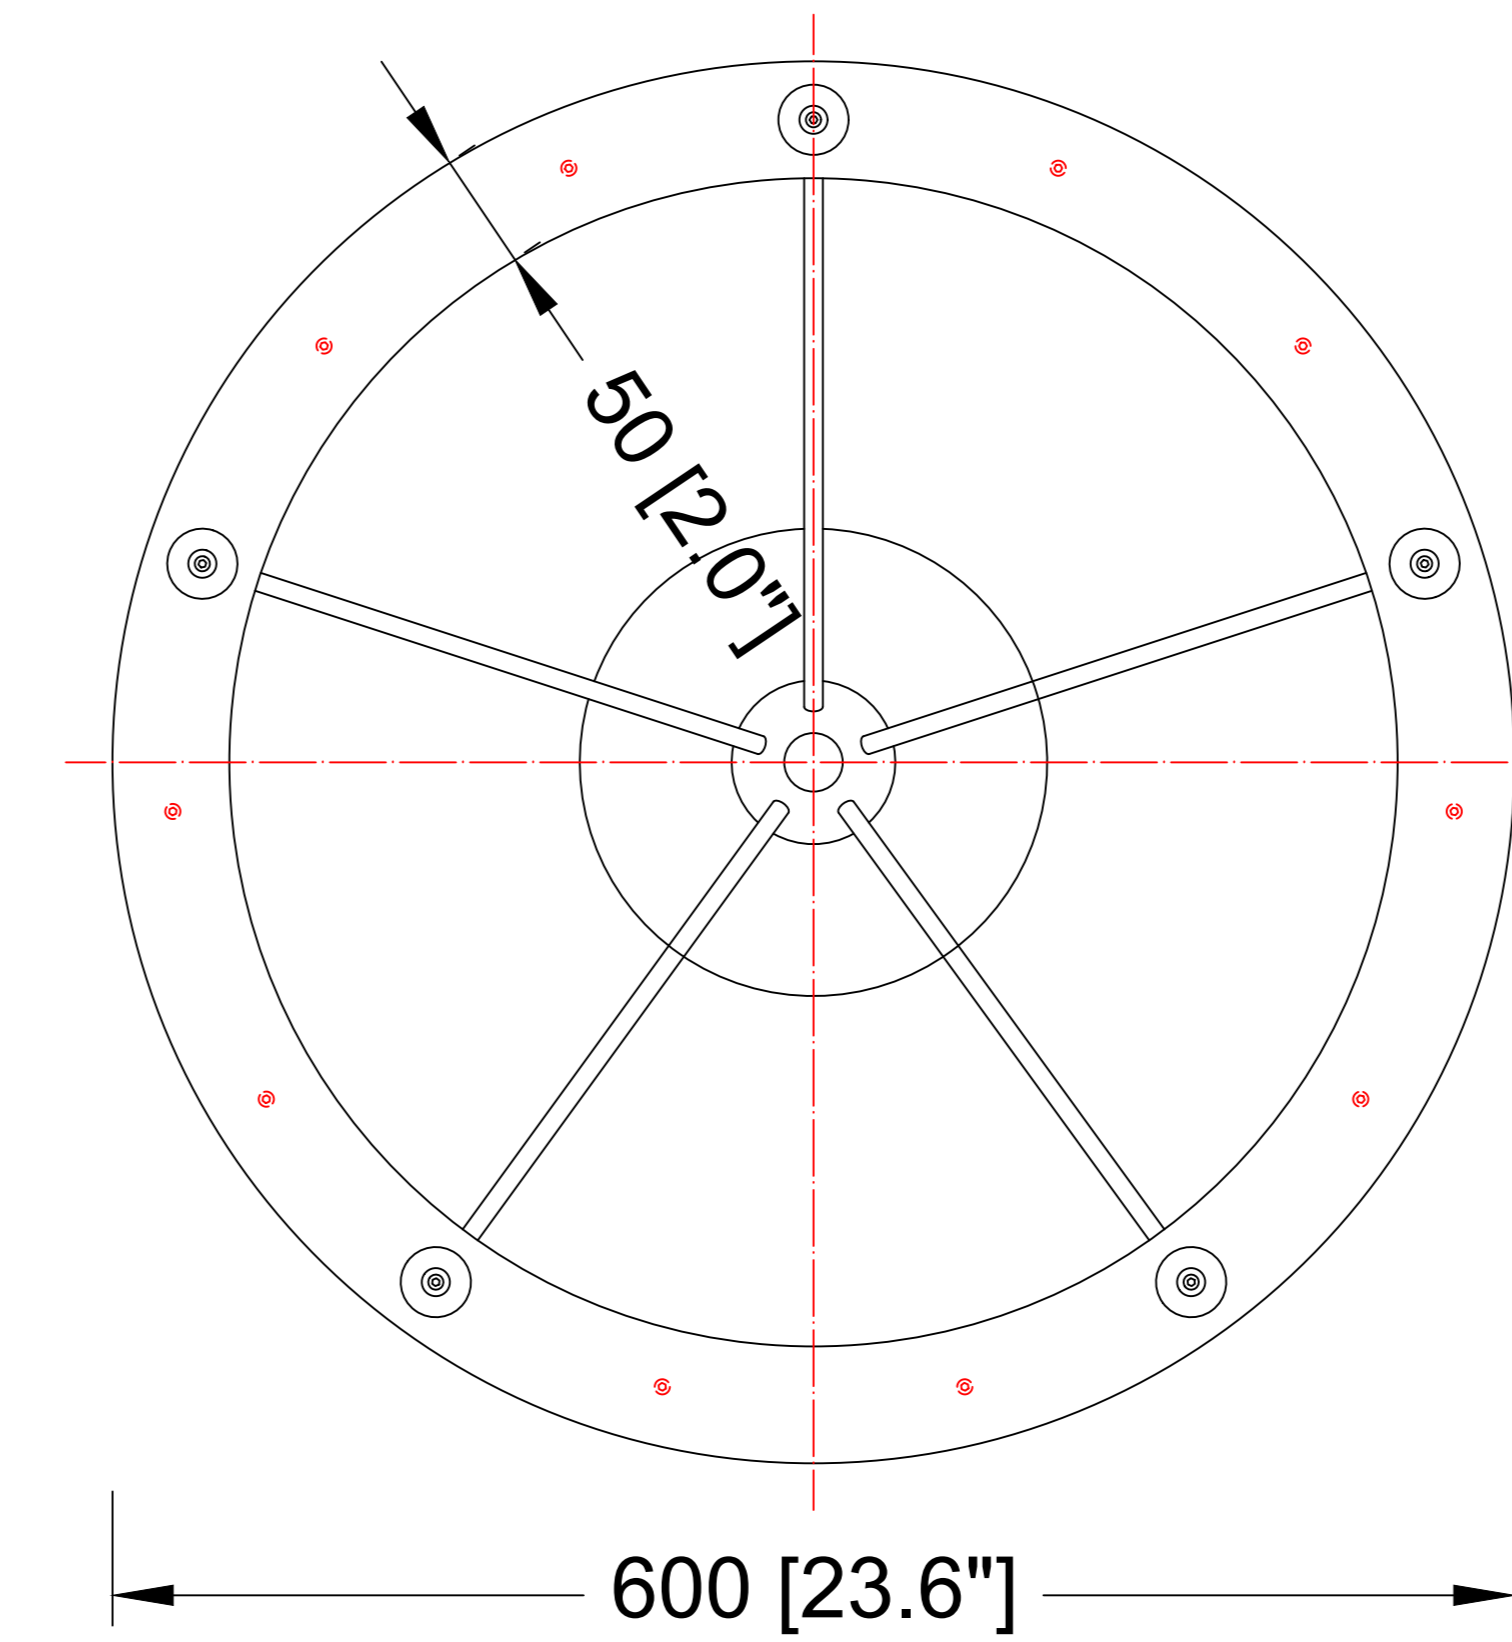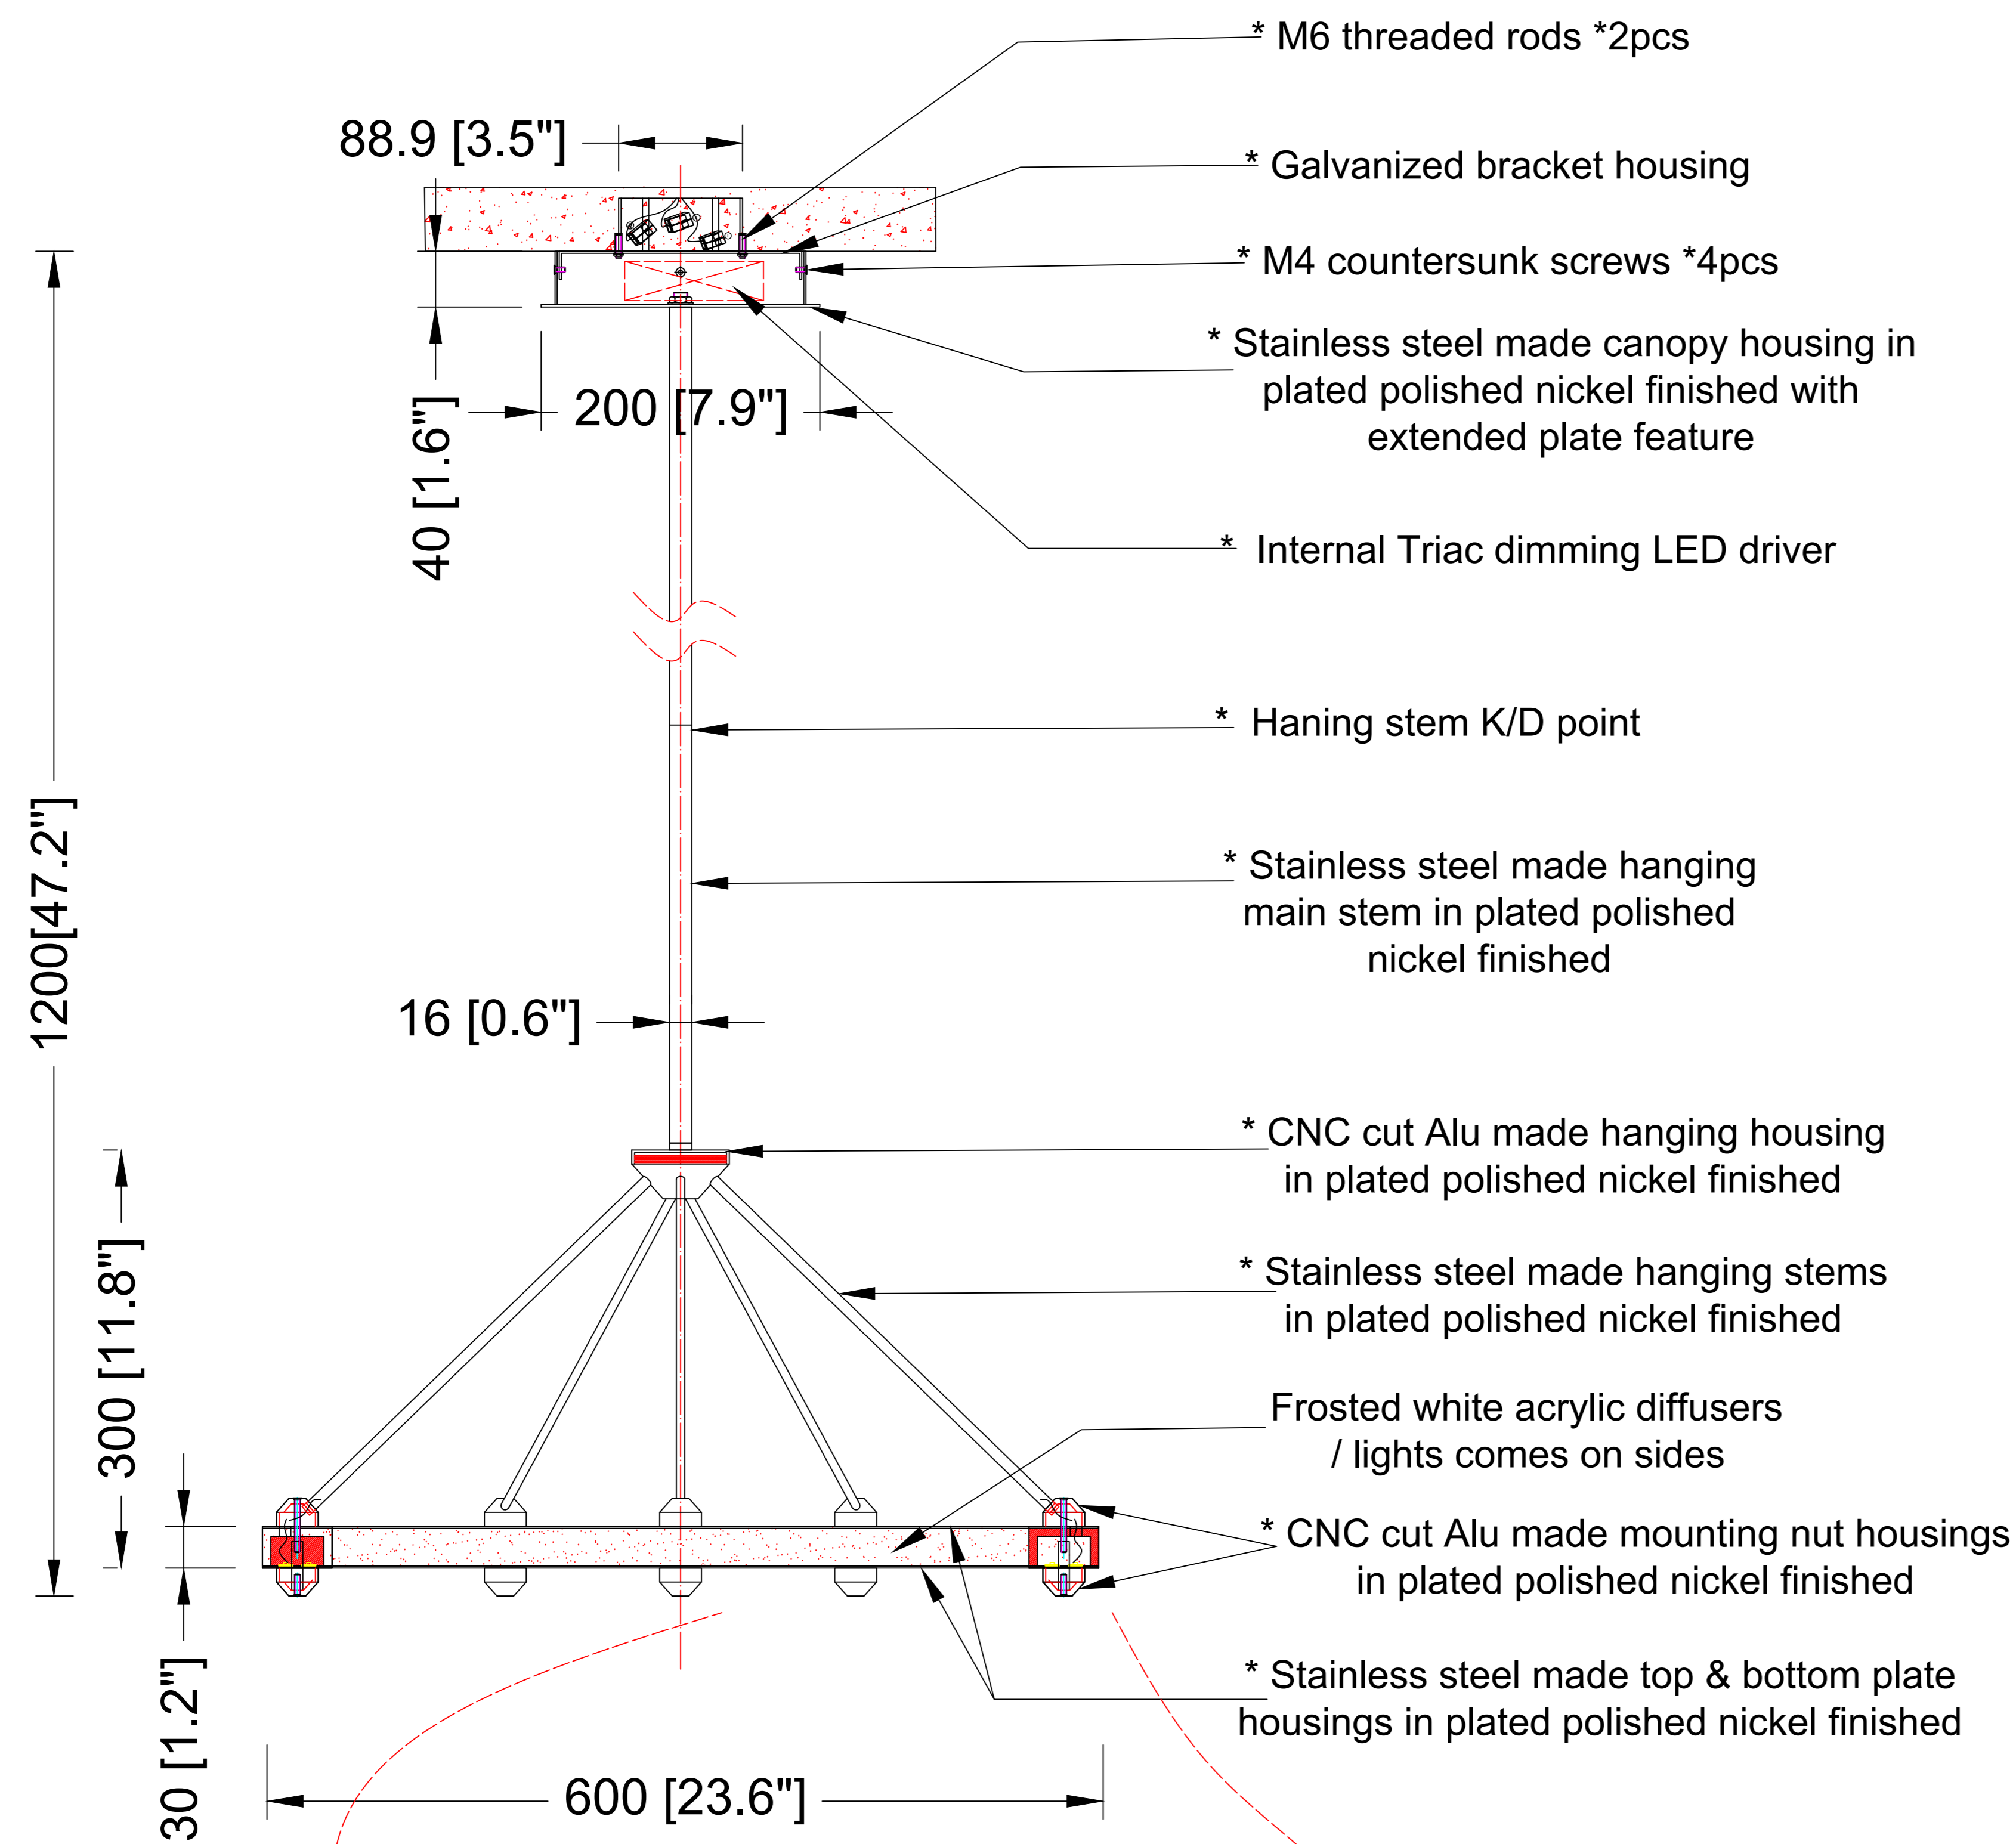

Ref Pic

SCALE: NTS



Reef Lighting, Inc. reserves the right to change or modify the product specifications without notification.