


REEF LIGHTING
WHERE LIGHT TOUCHES THE SEA

PROJECT:

PO 5230

±5MM
Size tolerance
± 1/2°
Angle tolerance

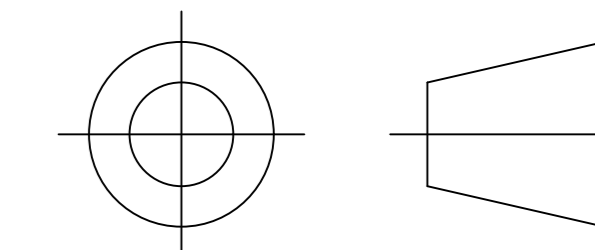

Date: 26-07-2023

Revision:

Type: Pendant lamp

Item No: 9890-1

Dwg by:

Verification by:

Scale: 1:8

Area/Location:

Dimension:
7.1"L x 3.5"W x 120"OAH

Finish: Matte black + White

Materials: Iron + Alu + Acrylic

Weight: 2 kgs

Light: Osram LED light 3W 3000K / None dimming

Qty: 10 pcs

Approved

Approved as noted

Revise & resubmit

Date: _____


Signature: _____

Notes:

- *1: Different design & size canopy from original.
- *2: Different mounting structure from original.
- *3: Different finished from original.
- *4: Different but similar lamp housing from original.




Reef Lighting, Inc. reserves the right to change or modify the product specifications without notification.

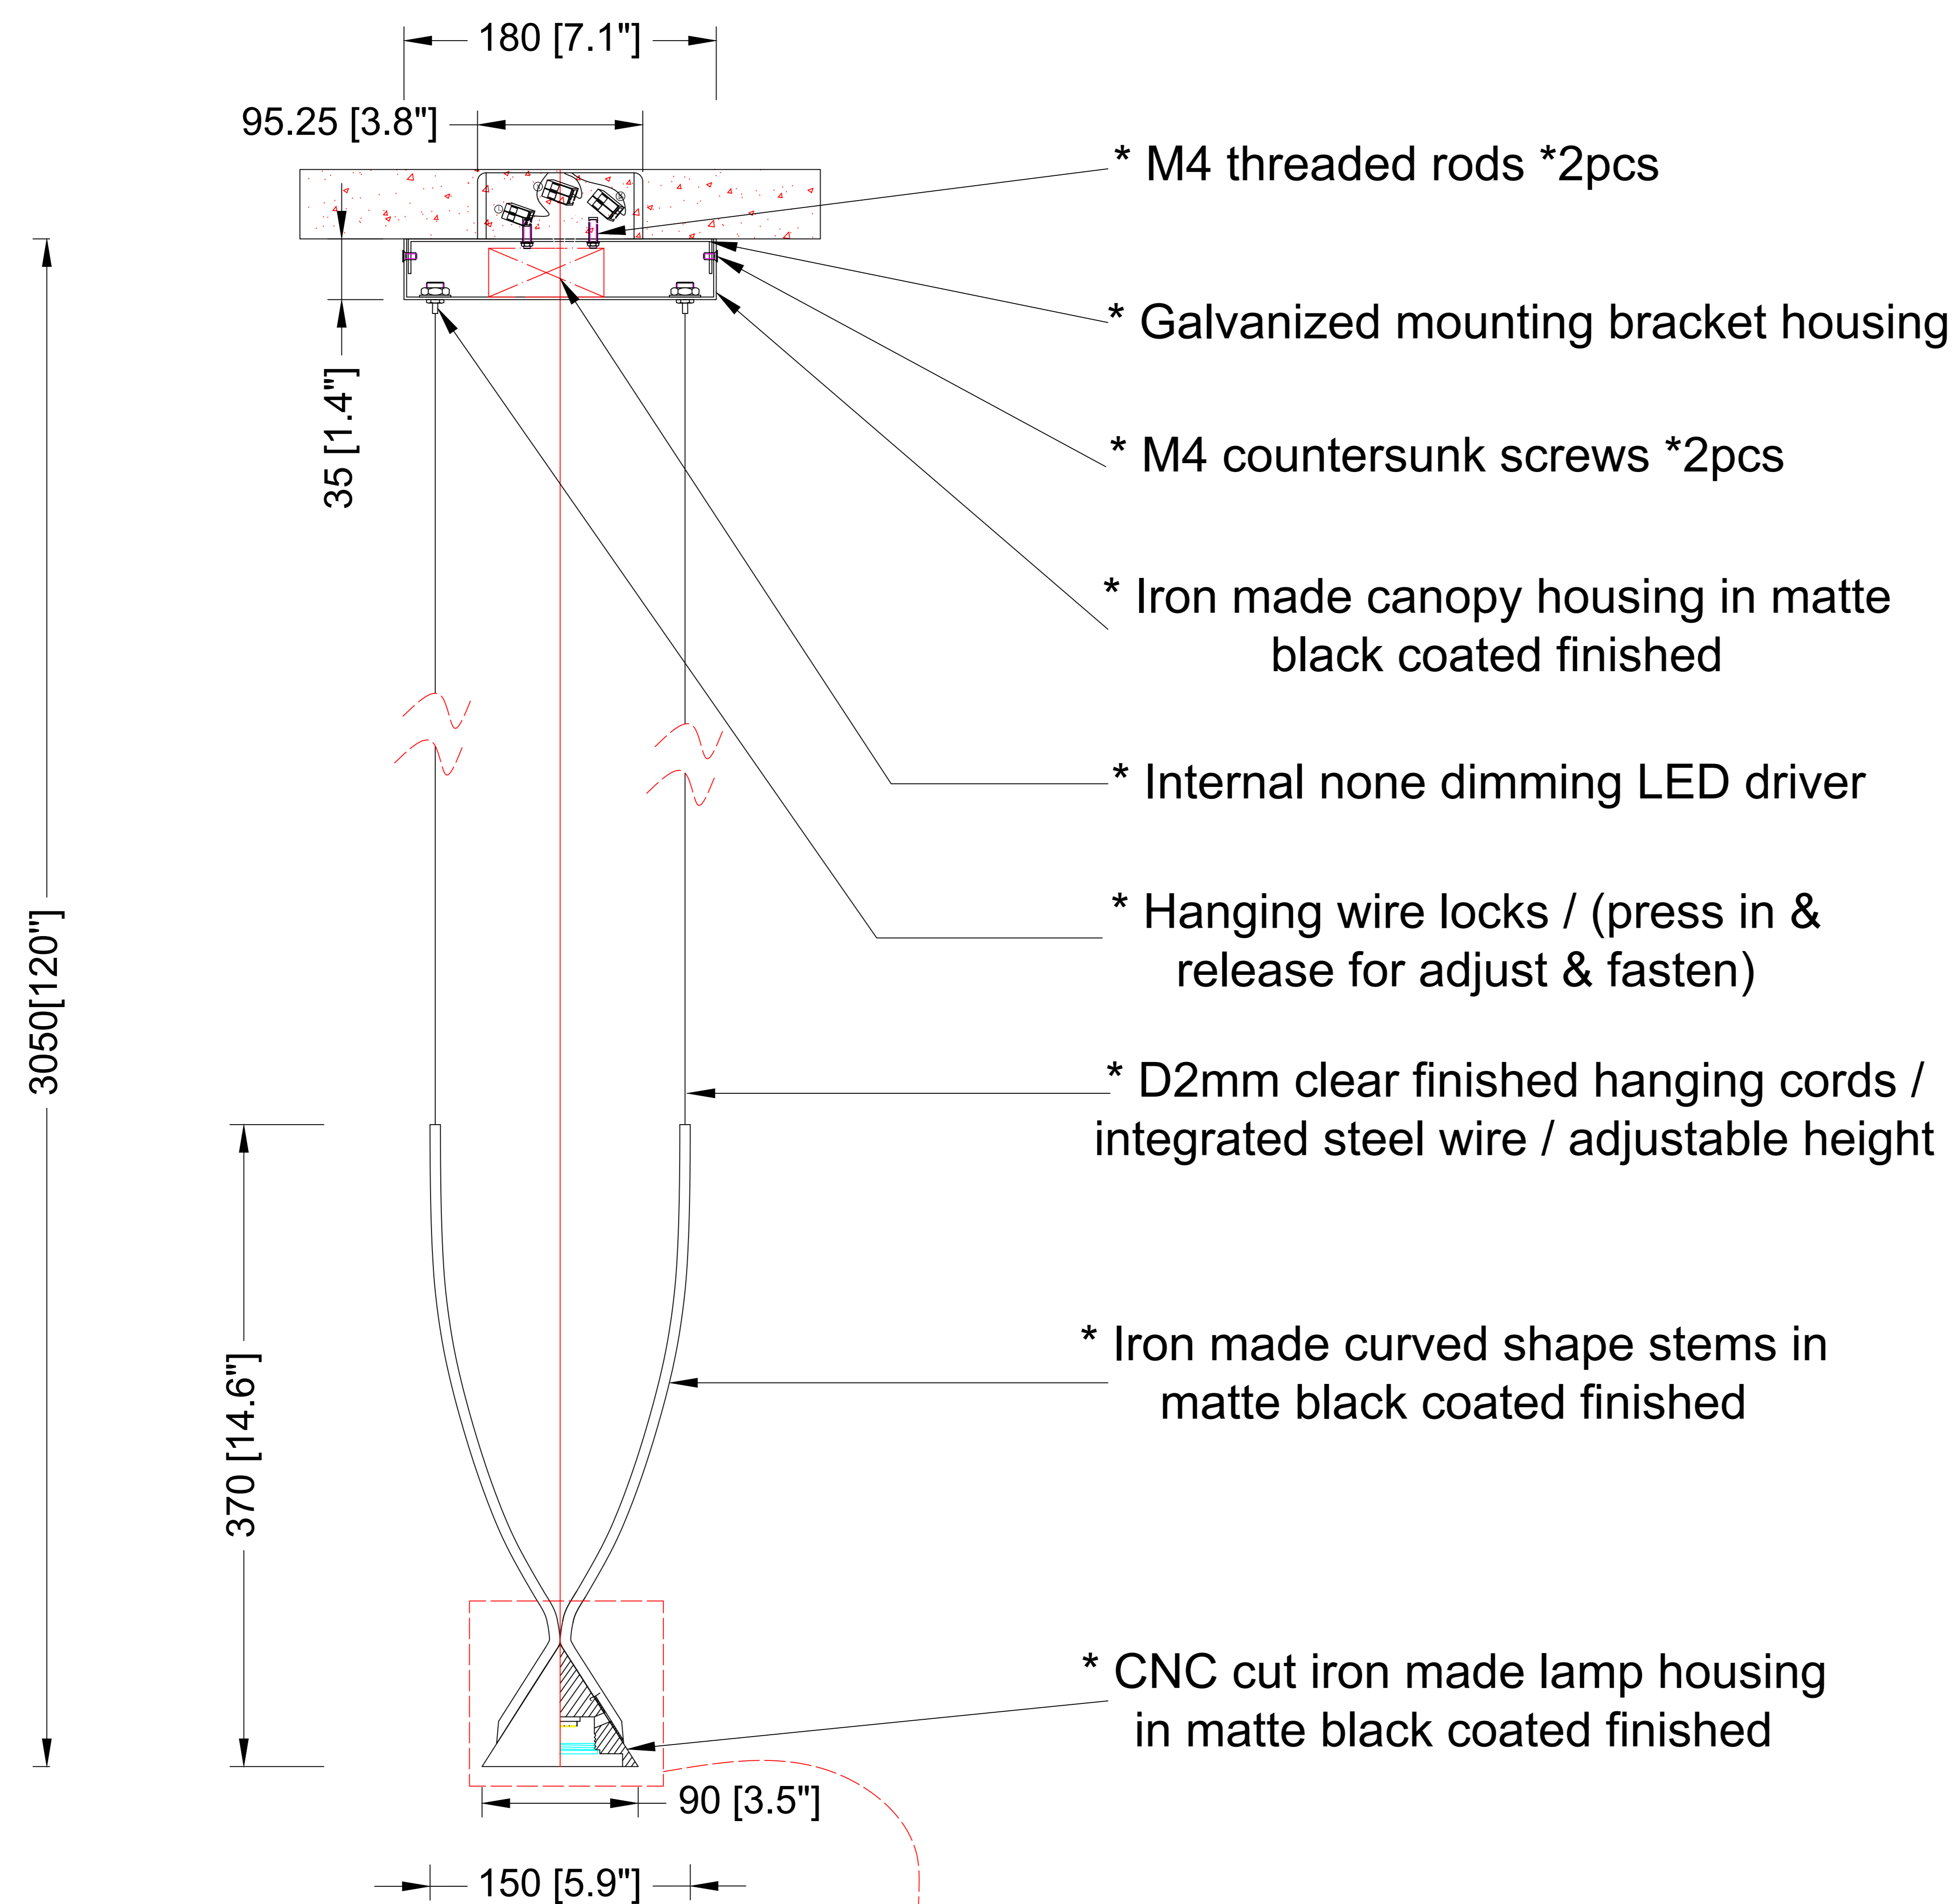


ELEVATION VIEW

SCALE: 1:8

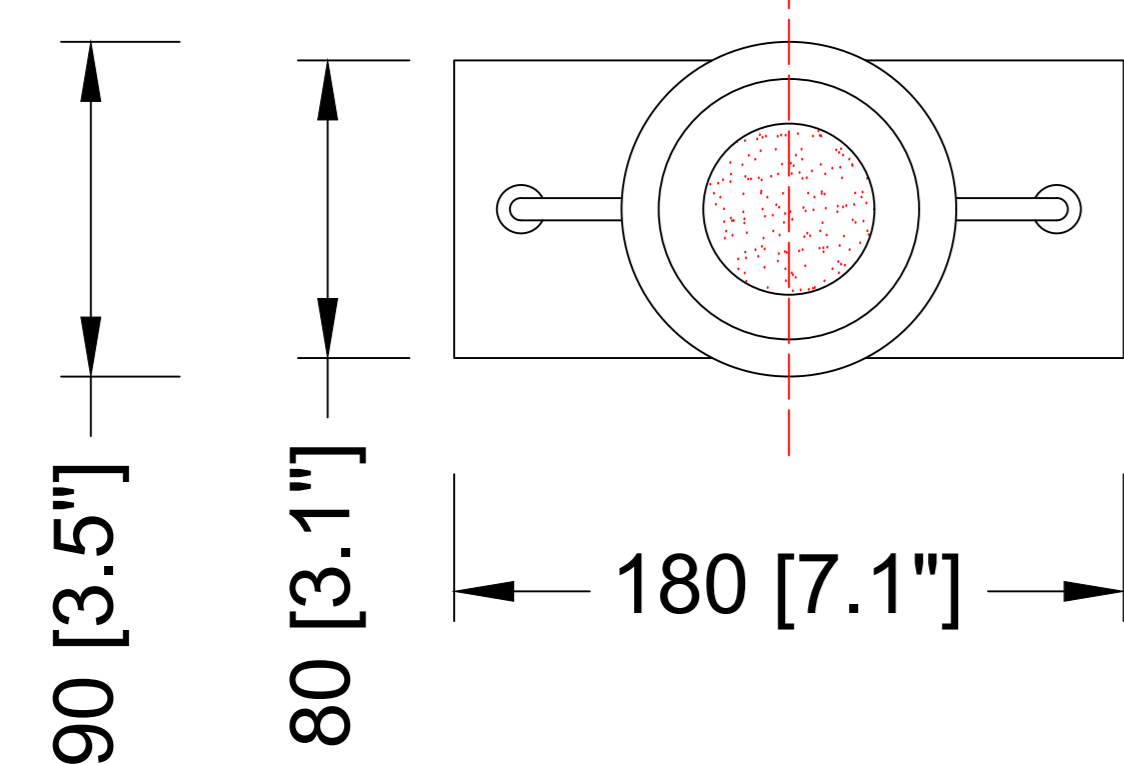


BOTTOM VIEW

SCALE: 1:8

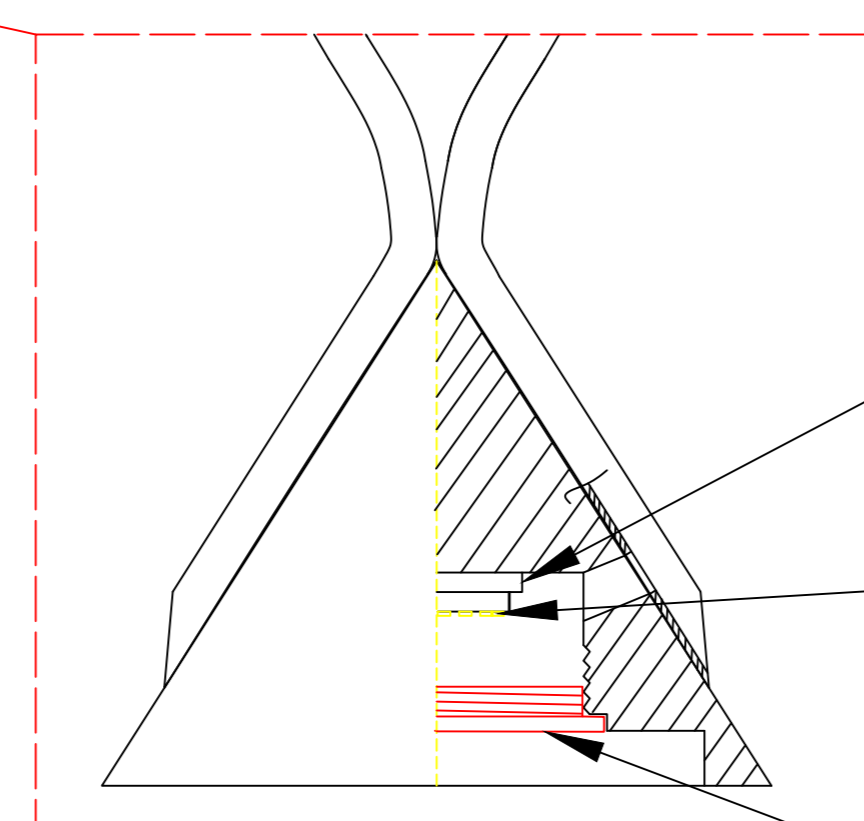

- * CNC cut Alu inner heatsink
- * LED 3W lighting 3000K / None dimming
- * Threaded Alu ring with bottom white finished acrylic diffuser

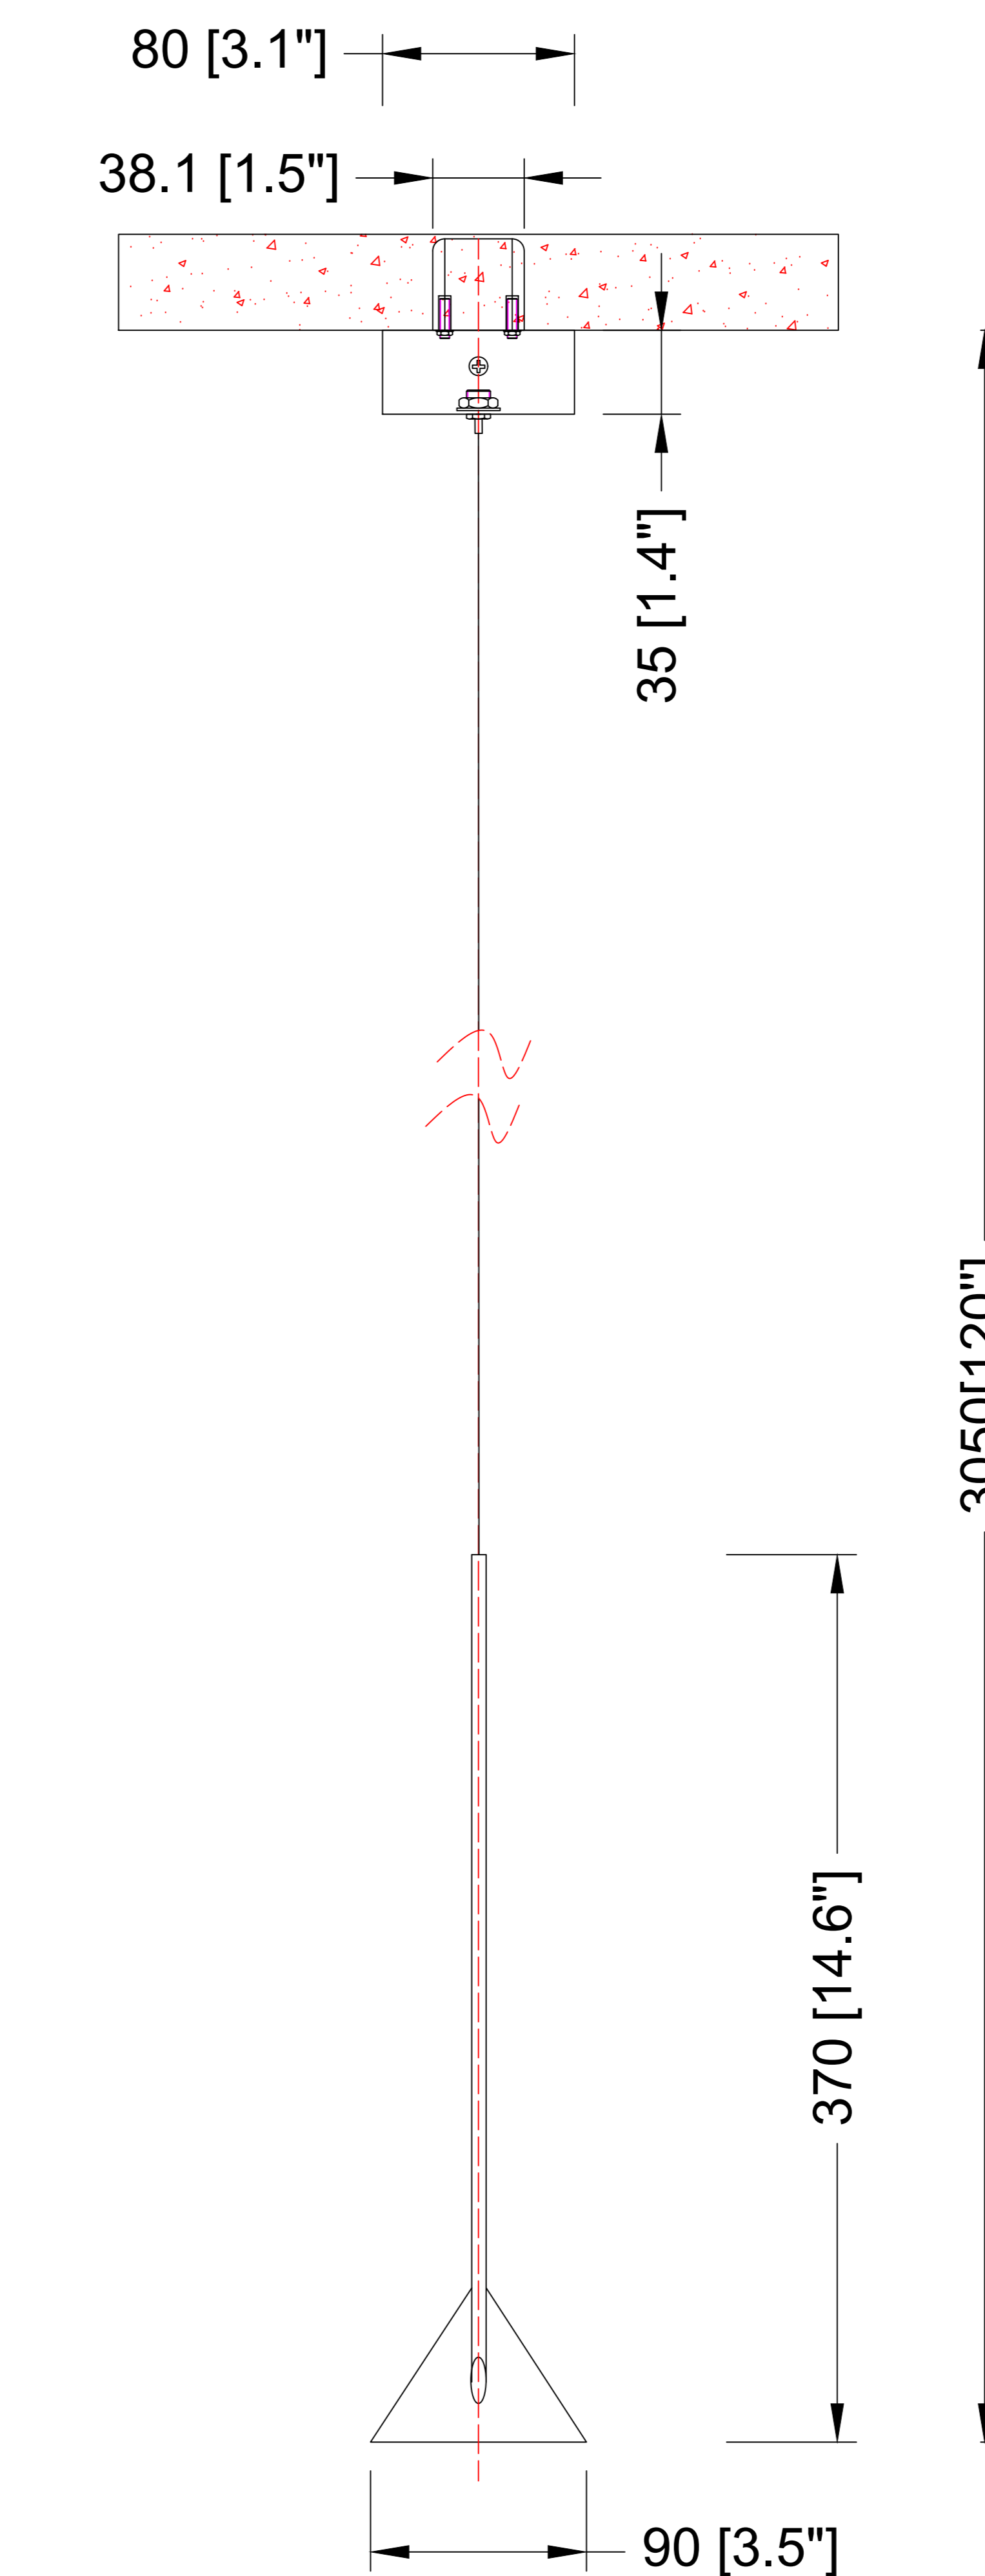

SIDE VIEW

SCALE: 1:8



Ref Pic

SCALE: NTS